





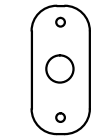



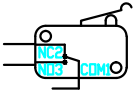
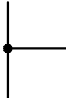

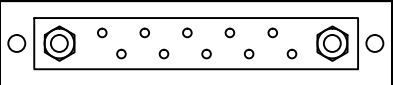
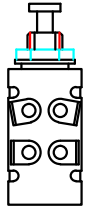
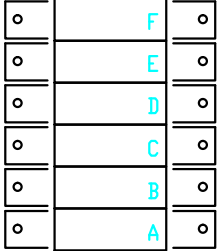



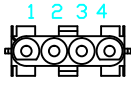

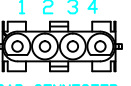


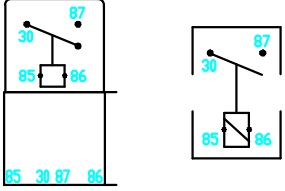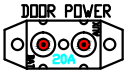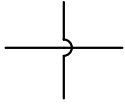

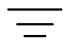

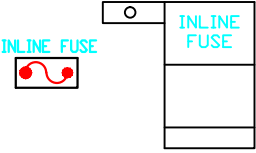



















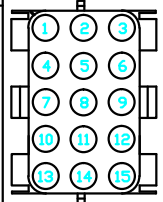
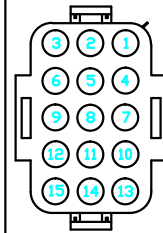
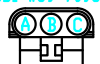



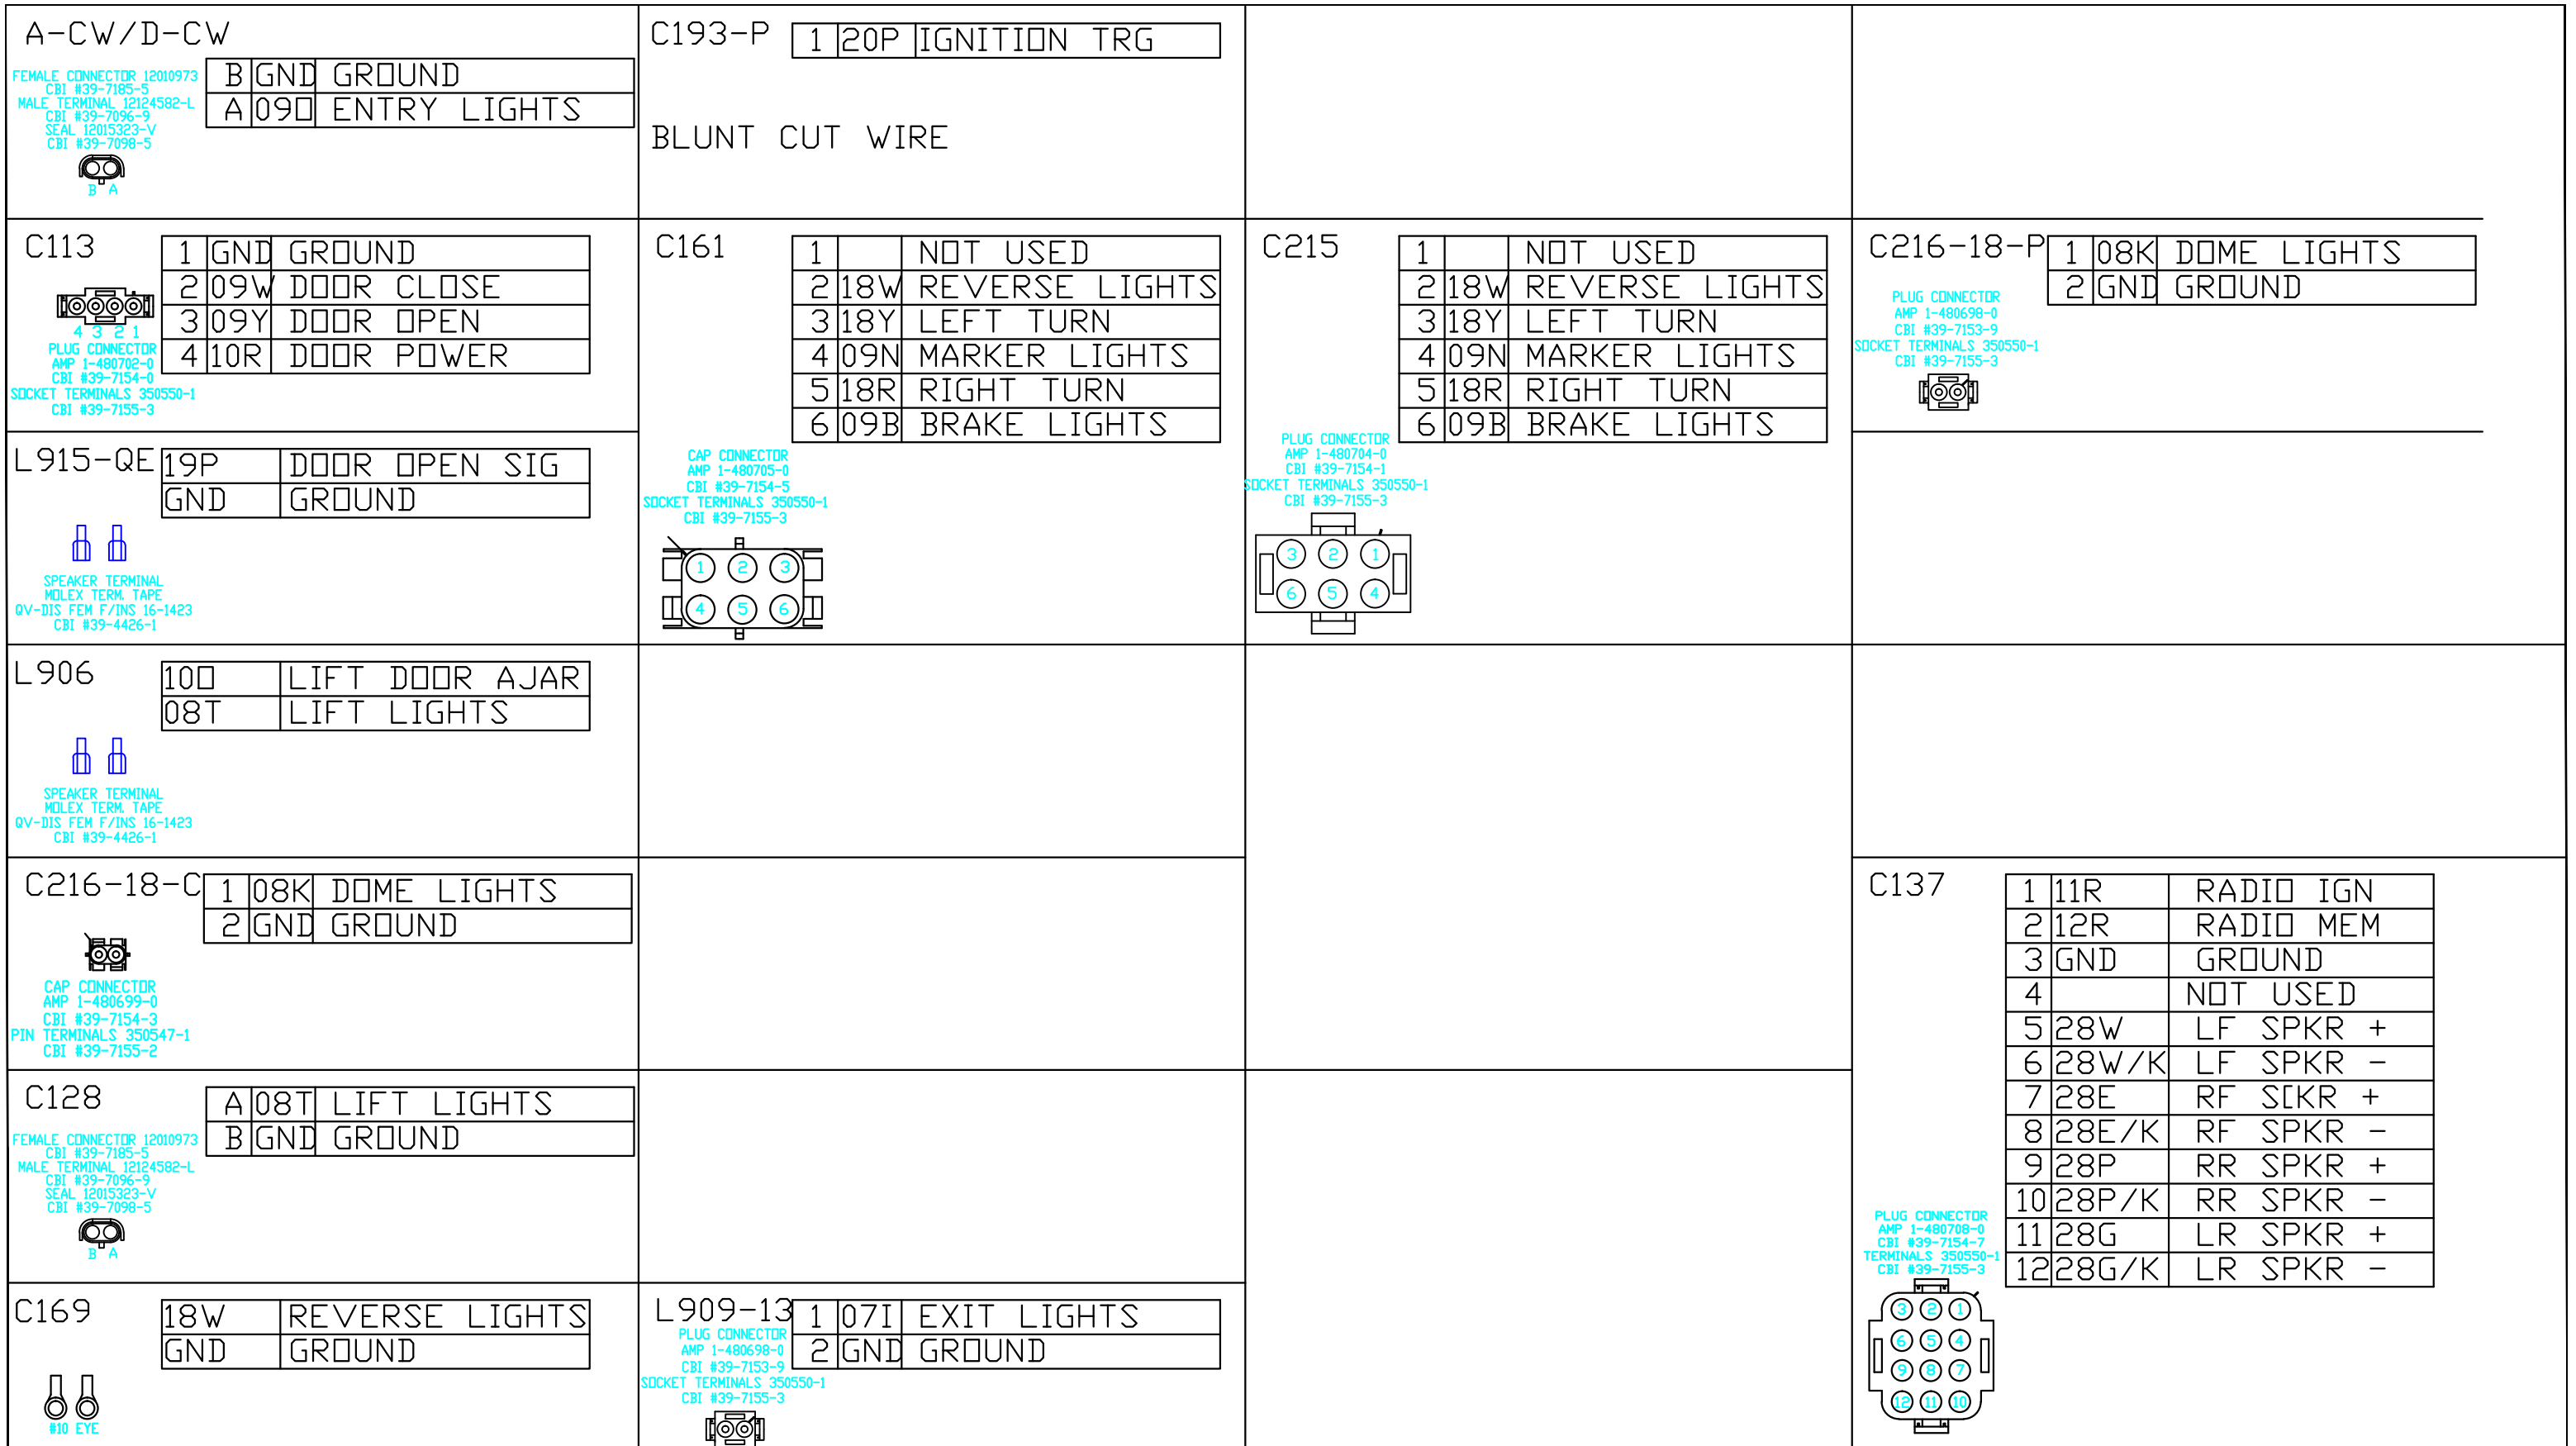
F#	VALUE	FUNCTION	CONNECTOR
F1	5	BUZZER	J3,3
F2	10	STEP LIGHTS IGN	J4,1
F3	15	BACKUP CAMERA	J3,6
F4	NA	NOT USED	-179-J
F5	15	STEP HEAT	J11,1
F6	5	AC IGNITION	J4,2
F7	5	RADIO PREP	-177-E
F8	15	DOME/CENTER LIGHT	J11,2/J11,3/J61
F9	5	HEAT 1	-177-G
F10	10	F CLEARANCE/SWITCH/DESTSIGN LT	J1,2/J1,3/J9,1
F11	5	REAR DR BUZZ RLY	J3,5/-178-C
F12	15	RELAY POWER/DEST SIGN	J9,2/J10,2
F13	NA	NOT USED	J3,4
F14	15	DASH SWITCH IGN	J3,5
F15	NA	NOT USED	J8,1
F16	NA	NOT USED	J7,1
F17	20	DOOR BATTERY	J2,1
F18	15	DOOR SWITCH, LIFT, LIFT LIGHTS	J1,1
F19	15	RADIO BATTERY	J2,2
F20	15	CAMERA IGNITION	J3,2
F21		SPARE IGNITION	J3,1
F22		SPARE BATTERY	J2,3
F23		SPARE BATTERY	J2,4
F24		SPARE BATTERY	J2,5

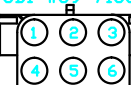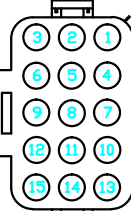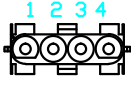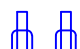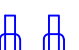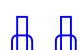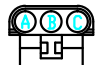
 <p>12 VOLT RELAY</p>	 <p>POST BREAKER</p>	 <p>WIRE NOT CONNECTED</p>																													
 <p>GROUND LOCATION</p>	 <p>INLINE FUSE</p>	 <p>GROUND INPUT</p>																													
 <p>POWER STUD</p>	 <p>BREAKER</p>	 <p>CONNECTION POINT</p>																													
 <p>DIODE</p>	 <p>MICRO SWITCH</p>																														
 <p>WIRE CONNECTED</p>	 <p>BATTERY DISCONNECT</p>		<p>WIRE COLOR CODES</p>																												
 <p>GROUND BAR</p>	 <p>DPDT JAMB SWITCH</p>	 <p>FUSE BLOCK</p>	<table border="1"> <thead> <tr> <th colspan="4">COLOR CODES</th> </tr> </thead> <tbody> <tr> <td>B</td> <td>BLUE</td> <td>O</td> <td>ORANGE</td> </tr> <tr> <td>E</td> <td>GREY</td> <td>P</td> <td>PURPLE</td> </tr> <tr> <td>G</td> <td>GREEN</td> <td>R</td> <td>RED</td> </tr> <tr> <td>K</td> <td>BLACK</td> <td>T</td> <td>TAN</td> </tr> <tr> <td>I</td> <td>PINK</td> <td>Y</td> <td>YELLOW</td> </tr> <tr> <td>N</td> <td>BROWN</td> <td>W</td> <td>WHITE</td> </tr> </tbody> </table>	COLOR CODES				B	BLUE	O	ORANGE	E	GREY	P	PURPLE	G	GREEN	R	RED	K	BLACK	T	TAN	I	PINK	Y	YELLOW	N	BROWN	W	WHITE
COLOR CODES																															
B	BLUE	O	ORANGE																												
E	GREY	P	PURPLE																												
G	GREEN	R	RED																												
K	BLACK	T	TAN																												
I	PINK	Y	YELLOW																												
N	BROWN	W	WHITE																												

<p>C148-P</p> <table border="1"> <tr><td>1</td><td>18Y</td><td>LH TURN SIGNAL</td></tr> <tr><td>2</td><td>GND</td><td>GROUND</td></tr> </table> <p>PLUG CONNECTOR AMP 1-480698-0 CBI #39-7153-9 PIN TERMINALS 350547-1 CBI #39-7155-2</p> 	1	18Y	LH TURN SIGNAL	2	GND	GROUND	<p>C110-C</p> <table border="1"> <tr><td>1</td><td>04I</td><td>LIFT STOWED</td></tr> <tr><td>2</td><td>GND</td><td>GROUND</td></tr> </table> <p>CAP CONNECTOR AMP 1-480699-0 CBI #39-7154-3 PIN TERMINALS 350547-1 CBI #39-7155-2</p> 	1	04I	LIFT STOWED	2	GND	GROUND	<p>C118-C</p> <table border="1"> <tr><td>1</td><td>08K</td><td>DOME LIGHTS</td></tr> <tr><td>2</td><td>GND</td><td>GROUND</td></tr> </table> <p>CAP CONNECTOR AMP 1-480699-0 CBI #39-7154-3 PIN TERMINALS 350547-1 CBI #39-7155-2</p> 	1	08K	DOME LIGHTS	2	GND	GROUND	<p>C116-C</p> <table border="1"> <tr><td>1</td><td>09W</td><td>DOOR CLOSE</td></tr> <tr><td>2</td><td>GND</td><td>GROUND</td></tr> <tr><td>3</td><td>09Y</td><td>DOOR OPEN</td></tr> <tr><td>4</td><td>10R</td><td>DOOR BATT PWR</td></tr> </table> <p>CAP CONNECTOR AMP 1-480703-0 CBI #39-7154-4 PIN TERMINALS 350547-1 CBI #39-7155-2</p> 	1	09W	DOOR CLOSE	2	GND	GROUND	3	09Y	DOOR OPEN	4	10R	DOOR BATT PWR																																																																								
1	18Y	LH TURN SIGNAL																																																																																																							
2	GND	GROUND																																																																																																							
1	04I	LIFT STOWED																																																																																																							
2	GND	GROUND																																																																																																							
1	08K	DOME LIGHTS																																																																																																							
2	GND	GROUND																																																																																																							
1	09W	DOOR CLOSE																																																																																																							
2	GND	GROUND																																																																																																							
3	09Y	DOOR OPEN																																																																																																							
4	10R	DOOR BATT PWR																																																																																																							
<p>C150-P</p> <table border="1"> <tr><td>1</td><td>18W</td><td>LH REVERSE LT</td></tr> <tr><td>2</td><td>GND</td><td>GROUND</td></tr> </table> <p>PLUG CONNECTOR AMP 1-480698-0 CBI #39-7153-9 PIN TERMINALS 350547-1 CBI #39-7155-2</p> 	1	18W	LH REVERSE LT	2	GND	GROUND	<p>C108-C</p> <table border="1"> <tr><td>1</td><td>04P</td><td>HEATER #2 HIGH</td></tr> <tr><td>2</td><td></td><td></td></tr> <tr><td>3</td><td>04Q</td><td>HEATER #2 LOW</td></tr> <tr><td>4</td><td>GND</td><td>HEATER GROUND</td></tr> </table> <p>CAP CONNECTOR AMP 1-480703-0 CBI #39-7154-4 PIN TERMINALS 350547-1 CBI #39-7155-2</p> 	1	04P	HEATER #2 HIGH	2			3	04Q	HEATER #2 LOW	4	GND	HEATER GROUND	<p>C154-C</p> <table border="1"> <tr><td>1</td><td>08K</td><td>DOME LIGHTS</td></tr> <tr><td>2</td><td>GND</td><td>GROUND</td></tr> </table> <p>CAP CONNECTOR AMP 1-480699-0 CBI #39-7154-3 PIN TERMINALS 350547-1 CBI #39-7155-2</p> 	1	08K	DOME LIGHTS	2	GND	GROUND	<p>C165-C</p> <table border="1"> <tr><td>1</td><td>GND</td><td>GROUND</td></tr> <tr><td>2</td><td>09Q</td><td>ENTRY LIGHTS</td></tr> </table> <p>CAP CONNECTOR AMP 1-480699-0 CBI #39-7154-3 PIN TERMINALS 350547-1 CBI #39-7155-2</p> 	1	GND	GROUND	2	09Q	ENTRY LIGHTS																																																																								
1	18W	LH REVERSE LT																																																																																																							
2	GND	GROUND																																																																																																							
1	04P	HEATER #2 HIGH																																																																																																							
2																																																																																																									
3	04Q	HEATER #2 LOW																																																																																																							
4	GND	HEATER GROUND																																																																																																							
1	08K	DOME LIGHTS																																																																																																							
2	GND	GROUND																																																																																																							
1	GND	GROUND																																																																																																							
2	09Q	ENTRY LIGHTS																																																																																																							
<p>C190E/F-C</p> <table border="1"> <tr><td>A</td><td>09N</td><td>MARKER LIGHTS</td></tr> <tr><td>B</td><td>GND</td><td>GROUND</td></tr> </table> <p>FEMALE CONNECTOR 12010973 CBI #39-7185-5 MALE TERMINAL 12124582-L CBI #39-7096-9 SEAL 12015323-V CBI #39-7098-5</p> 	A	09N	MARKER LIGHTS	B	GND	GROUND	<p>C108A-P</p> <table border="1"> <tr><td>1</td><td>04P</td><td>HEATER #2 HIGH</td></tr> <tr><td>2</td><td></td><td></td></tr> <tr><td>3</td><td>04Q</td><td>HEATER #2 LOW</td></tr> <tr><td>4</td><td>GND</td><td>HEATER GROUND</td></tr> </table> <p>PLUG CONNECTOR AMP 1-480702-0 CBI #39-7154-0 SOCKET TERMINALS 350550-1 CBI #39-7155-3</p> 	1	04P	HEATER #2 HIGH	2			3	04Q	HEATER #2 LOW	4	GND	HEATER GROUND	<p>C154-P</p> <table border="1"> <tr><td>1</td><td>08K</td><td>DOME LIGHTS</td></tr> <tr><td>2</td><td>GND</td><td>GROUND</td></tr> </table> <p>PLUG CONNECTOR AMP 1-480698-0 CBI #39-7153-9 SOCKET TERMINALS 350550-1 CBI #39-7155-3</p> 	1	08K	DOME LIGHTS	2	GND	GROUND	<p>C165-P</p> <table border="1"> <tr><td>1</td><td>GND</td><td>GROUND</td></tr> <tr><td>2</td><td>09Q</td><td>ENTRY LIGHTS</td></tr> </table> <p>PLUG CONNECTOR AMP 1-480698-0 CBI #39-7153-9 SOCKET TERMINALS 350550-1 CBI #39-7155-3</p> 	1	GND	GROUND	2	09Q	ENTRY LIGHTS																																																																								
A	09N	MARKER LIGHTS																																																																																																							
B	GND	GROUND																																																																																																							
1	04P	HEATER #2 HIGH																																																																																																							
2																																																																																																									
3	04Q	HEATER #2 LOW																																																																																																							
4	GND	HEATER GROUND																																																																																																							
1	08K	DOME LIGHTS																																																																																																							
2	GND	GROUND																																																																																																							
1	GND	GROUND																																																																																																							
2	09Q	ENTRY LIGHTS																																																																																																							
<p>C190-C</p> <table border="1"> <tr><td>1</td><td>09N</td><td>MARKER LIGHTS</td></tr> <tr><td>2</td><td>GND</td><td>GROUND</td></tr> </table> <p>CAP CONNECTOR AMP 1-480699-0 CBI #39-7154-3 PIN TERMINALS 350547-1 CBI #39-7155-2</p> 	1	09N	MARKER LIGHTS	2	GND	GROUND	<p>C108-P</p> <table border="1"> <tr><td>1</td><td>07P</td><td>HEATER #1 HIGH</td></tr> <tr><td>2</td><td></td><td></td></tr> <tr><td>3</td><td>07Q</td><td>HEATER #1 LOW</td></tr> <tr><td>4</td><td>GND</td><td>HEATER GROUND</td></tr> </table> <p>PLUG CONNECTOR AMP 1-480702-0 CBI #39-7154-0 SOCKET TERMINALS 350550-1 CBI #39-7155-3</p> 	1	07P	HEATER #1 HIGH	2			3	07Q	HEATER #1 LOW	4	GND	HEATER GROUND	<p>C157-C</p> <table border="1"> <tr><td>1</td><td>07I</td><td>EXIT LIGHTS</td></tr> <tr><td>2</td><td>GND</td><td>GROUND</td></tr> </table> <p>CAP CONNECTOR AMP 1-480699-0 CBI #39-7154-3 PIN TERMINALS 350547-1 CBI #39-7155-2</p> 	1	07I	EXIT LIGHTS	2	GND	GROUND	<p>C163B-P</p> <table border="1"> <tr><td>1</td><td>08AI</td><td>LIFT LIGHTS</td></tr> <tr><td>2</td><td>10B</td><td>LIFT POWER</td></tr> <tr><td>3</td><td>GND</td><td>GROUND</td></tr> <tr><td>4</td><td>10D</td><td>LIFT DOOR AJAR</td></tr> </table> <p>PLUG CONNECTOR AMP 1-480702-0 CBI #39-7154-0 PIN TERMINALS 350547-1 CBI #39-7155-2</p> 	1	08AI	LIFT LIGHTS	2	10B	LIFT POWER	3	GND	GROUND	4	10D	LIFT DOOR AJAR																																																																		
1	09N	MARKER LIGHTS																																																																																																							
2	GND	GROUND																																																																																																							
1	07P	HEATER #1 HIGH																																																																																																							
2																																																																																																									
3	07Q	HEATER #1 LOW																																																																																																							
4	GND	HEATER GROUND																																																																																																							
1	07I	EXIT LIGHTS																																																																																																							
2	GND	GROUND																																																																																																							
1	08AI	LIFT LIGHTS																																																																																																							
2	10B	LIFT POWER																																																																																																							
3	GND	GROUND																																																																																																							
4	10D	LIFT DOOR AJAR																																																																																																							
<p>C145-P</p> <table border="1"> <tr><td>1</td><td>09B</td><td>CEN.BRAKE LIGHT</td></tr> <tr><td>2</td><td>GND</td><td>GROUND</td></tr> </table> <p>PLUG CONNECTOR AMP 1-480698-0 CBI #39-7153-9 PIN TERMINALS 350547-1 CBI #39-7155-2</p> 	1	09B	CEN.BRAKE LIGHT	2	GND	GROUND	<p>C109-C</p> <table border="1"> <tr><td>1</td><td>09N</td><td>MARKER LIGHT</td></tr> <tr><td>2</td><td>GND</td><td>GROUND</td></tr> </table> <p>CAP CONNECTOR AMP 1-480699-0 CBI #39-7154-3 PIN TERMINALS 350547-1 CBI #39-7155-2</p> 	1	09N	MARKER LIGHT	2	GND	GROUND	<p>C106-C</p> <table border="1"> <tr><td>1</td><td>02P</td><td>AUX POWER</td></tr> <tr><td>2</td><td>18W</td><td>REVERSE SIGNAL</td></tr> <tr><td>3</td><td>GND</td><td>GROUND</td></tr> <tr><td>4</td><td>09N</td><td>MARKER LIGHTS</td></tr> <tr><td>5</td><td></td><td>NOT USED</td></tr> <tr><td>6</td><td>18R</td><td>RIGHT TURN SIG</td></tr> <tr><td>7</td><td>03T</td><td>REAR LUGG. LT</td></tr> <tr><td>8</td><td>GND</td><td>GROUND</td></tr> <tr><td>9</td><td>09B</td><td>BRAKE LIGHTS</td></tr> <tr><td>10</td><td>23Y</td><td>WINDOW AJAR</td></tr> <tr><td>11</td><td>18Y</td><td>LEFT TURN SIG</td></tr> <tr><td>12</td><td>07I</td><td>EXIT LIGHTS</td></tr> <tr><td>13</td><td></td><td>NOT USED</td></tr> <tr><td>14</td><td>18Q</td><td>7" LIGHT</td></tr> <tr><td>15</td><td>03E</td><td>REAR DOOR AJAR</td></tr> </table> <p>CAP CONNECTOR AMP 1-480711-0 CBI #39-7155-1 TER. 350547-1 CBI #39-7155-2</p> 	1	02P	AUX POWER	2	18W	REVERSE SIGNAL	3	GND	GROUND	4	09N	MARKER LIGHTS	5		NOT USED	6	18R	RIGHT TURN SIG	7	03T	REAR LUGG. LT	8	GND	GROUND	9	09B	BRAKE LIGHTS	10	23Y	WINDOW AJAR	11	18Y	LEFT TURN SIG	12	07I	EXIT LIGHTS	13		NOT USED	14	18Q	7" LIGHT	15	03E	REAR DOOR AJAR	<p>C106-P</p> <table border="1"> <tr><td>1</td><td>02P</td><td>AUX POWER</td></tr> <tr><td>2</td><td>18W</td><td>BUZZER ALARM</td></tr> <tr><td>3</td><td>GND</td><td>GROUND</td></tr> <tr><td>4</td><td>09N</td><td>MARKER LIGHTS</td></tr> <tr><td>5</td><td></td><td>NOT USED</td></tr> <tr><td>6</td><td>18R</td><td>RIGHT TURN SIG</td></tr> <tr><td>7</td><td>03T</td><td>REAR LUGG. LT</td></tr> <tr><td>8</td><td>GND</td><td>GROUND</td></tr> <tr><td>9</td><td>09B</td><td>BRAKE LIGHTS</td></tr> <tr><td>10</td><td>23Y</td><td>WINDOW AJAR</td></tr> <tr><td>11</td><td>18Y</td><td>LEFT TURN SIG</td></tr> <tr><td>12</td><td>07I</td><td>EXIT LIGHTS</td></tr> <tr><td>13</td><td></td><td>NOT USED</td></tr> <tr><td>14</td><td>18Q</td><td>7" LIGHT</td></tr> <tr><td>15</td><td>03E</td><td>REAR DOOR AJAR</td></tr> </table> <p>PLUG CONNECTOR AMP 1-480710-0 CBI #39-7154-8 TER 350550-1 CBI #39-7155-3</p> 	1	02P	AUX POWER	2	18W	BUZZER ALARM	3	GND	GROUND	4	09N	MARKER LIGHTS	5		NOT USED	6	18R	RIGHT TURN SIG	7	03T	REAR LUGG. LT	8	GND	GROUND	9	09B	BRAKE LIGHTS	10	23Y	WINDOW AJAR	11	18Y	LEFT TURN SIG	12	07I	EXIT LIGHTS	13		NOT USED	14	18Q	7" LIGHT	15	03E	REAR DOOR AJAR
1	09B	CEN.BRAKE LIGHT																																																																																																							
2	GND	GROUND																																																																																																							
1	09N	MARKER LIGHT																																																																																																							
2	GND	GROUND																																																																																																							
1	02P	AUX POWER																																																																																																							
2	18W	REVERSE SIGNAL																																																																																																							
3	GND	GROUND																																																																																																							
4	09N	MARKER LIGHTS																																																																																																							
5		NOT USED																																																																																																							
6	18R	RIGHT TURN SIG																																																																																																							
7	03T	REAR LUGG. LT																																																																																																							
8	GND	GROUND																																																																																																							
9	09B	BRAKE LIGHTS																																																																																																							
10	23Y	WINDOW AJAR																																																																																																							
11	18Y	LEFT TURN SIG																																																																																																							
12	07I	EXIT LIGHTS																																																																																																							
13		NOT USED																																																																																																							
14	18Q	7" LIGHT																																																																																																							
15	03E	REAR DOOR AJAR																																																																																																							
1	02P	AUX POWER																																																																																																							
2	18W	BUZZER ALARM																																																																																																							
3	GND	GROUND																																																																																																							
4	09N	MARKER LIGHTS																																																																																																							
5		NOT USED																																																																																																							
6	18R	RIGHT TURN SIG																																																																																																							
7	03T	REAR LUGG. LT																																																																																																							
8	GND	GROUND																																																																																																							
9	09B	BRAKE LIGHTS																																																																																																							
10	23Y	WINDOW AJAR																																																																																																							
11	18Y	LEFT TURN SIG																																																																																																							
12	07I	EXIT LIGHTS																																																																																																							
13		NOT USED																																																																																																							
14	18Q	7" LIGHT																																																																																																							
15	03E	REAR DOOR AJAR																																																																																																							
<p>C163-C</p> <table border="1"> <tr><td>1</td><td>08AI</td><td>LIFT LIGHTS</td></tr> <tr><td>2</td><td>10B</td><td>LIFT POWER</td></tr> <tr><td>3</td><td>GND</td><td>GROUND</td></tr> <tr><td>4</td><td>10D</td><td>LIFT DOOR AJAR</td></tr> </table> <p>CAP CONNECTOR AMP 1-480703-0 CBI #39-7154-4 SOCKET TERMINALS 350550-1 CBI #39-7155-3</p> 	1	08AI	LIFT LIGHTS	2	10B	LIFT POWER	3	GND	GROUND	4	10D	LIFT DOOR AJAR	<p>C124</p> <table border="1"> <tr><td>28W</td><td>LEFT FRONT SPK</td></tr> <tr><td>28W/K</td><td>LEFT FRONT SPK</td></tr> </table> <p>SPEAKER TERMINAL MOLEX TERM. TAPE QV-DIS FEM F/INS 16-1423 CBI #39-4426-1</p> 	28W	LEFT FRONT SPK	28W/K	LEFT FRONT SPK																																																																																								
1	08AI	LIFT LIGHTS																																																																																																							
2	10B	LIFT POWER																																																																																																							
3	GND	GROUND																																																																																																							
4	10D	LIFT DOOR AJAR																																																																																																							
28W	LEFT FRONT SPK																																																																																																								
28W/K	LEFT FRONT SPK																																																																																																								
<p>C129</p> <table border="1"> <tr><td>28E</td><td>RT FRONT SPK</td></tr> <tr><td>28E/K</td><td>RT FRONT SPK</td></tr> </table> <p>SPEAKER TERMINAL MOLEX TERM. TAPE QV-DIS FEM F/INS 16-1423 CBI #39-4426-1</p> 	28E	RT FRONT SPK	28E/K	RT FRONT SPK	<p>L907</p> <table border="1"> <tr><td>08AI</td><td>LIFT LIGHTS</td></tr> <tr><td>GND</td><td>GROUND</td></tr> </table> <p>SPEAKER TERMINAL MOLEX TERM. TAPE QV-DIS FEM F/INS 16-1423 CBI #39-4426-1</p> 	08AI	LIFT LIGHTS	GND	GROUND																																																																																																
28E	RT FRONT SPK																																																																																																								
28E/K	RT FRONT SPK																																																																																																								
08AI	LIFT LIGHTS																																																																																																								
GND	GROUND																																																																																																								




<p>C147-PW</p> <table border="1"> <tr><td>A</td><td>09N</td><td>MARKER LIGHT</td></tr> <tr><td>B</td><td>18Y</td><td>LH TURN SIGNAL</td></tr> <tr><td>C</td><td>GND</td><td>GROUND</td></tr> </table> <p>MALE CONNECTOR 12020829 CBI #39-7214-5 MALE TERMINAL 12124582-L CBI #39-7096-9 SEAL 12015323-V CBI #39-7098-5</p> 	A	09N	MARKER LIGHT	B	18Y	LH TURN SIGNAL	C	GND	GROUND	<p>C187-P</p> <table border="1"> <tr><td>1</td><td>10B</td><td>LIFT POWER</td></tr> <tr><td>2</td><td>06Y</td><td>GATEWAY PWR</td></tr> <tr><td>3</td><td></td><td>NOT USED</td></tr> <tr><td>4</td><td>10Q</td><td>LIFT DOOR</td></tr> </table> <p>4 3 2 1 PLUG CONNECTOR AMP 1-480702-0 CBI #39-7154-0 SOCKET TERMINALS 350550-1 CBI #39-7155-3</p> 	1	10B	LIFT POWER	2	06Y	GATEWAY PWR	3		NOT USED	4	10Q	LIFT DOOR	<p>C189</p> <table border="1"> <tr><td>1</td><td>07I</td><td>EXIT LIGHTS</td></tr> <tr><td>2</td><td>GND</td><td>GROUND</td></tr> </table> <p>CAP CONNECTOR AMP 1-480699-0 CBI #39-7154-3 PIN TERMINALS 350547-1 CBI #39-7155-2</p> 	1	07I	EXIT LIGHTS	2	GND	GROUND	<p>C153</p> <table border="1"> <tr><td>1</td><td>09N</td><td>MARKER LIGHT</td></tr> <tr><td>2</td><td>GND</td><td>GROUND</td></tr> </table> <p>CAP CONNECTOR AMP 1-480699-0 CBI #39-7154-3 PIN TERMINALS 350547-1 CBI #39-7155-2</p> 	1	09N	MARKER LIGHT	2	GND	GROUND																																																															
A	09N	MARKER LIGHT																																																																																																	
B	18Y	LH TURN SIGNAL																																																																																																	
C	GND	GROUND																																																																																																	
1	10B	LIFT POWER																																																																																																	
2	06Y	GATEWAY PWR																																																																																																	
3		NOT USED																																																																																																	
4	10Q	LIFT DOOR																																																																																																	
1	07I	EXIT LIGHTS																																																																																																	
2	GND	GROUND																																																																																																	
1	09N	MARKER LIGHT																																																																																																	
2	GND	GROUND																																																																																																	
<p>C140-P</p> <table border="1"> <tr><td>1</td><td>09N</td><td>MARKER LIGHT</td></tr> <tr><td>2</td><td>09B</td><td>BRAKE LIGHT</td></tr> <tr><td>3</td><td>GND</td><td>GROUND</td></tr> </table> <p>PLUG CONNECTOR AMP 1-480700-0 CBI #B13-1914 PIN TERMINALS 350547-1 CBI #39-7155-2</p> 	1	09N	MARKER LIGHT	2	09B	BRAKE LIGHT	3	GND	GROUND																																																																																										
1	09N	MARKER LIGHT																																																																																																	
2	09B	BRAKE LIGHT																																																																																																	
3	GND	GROUND																																																																																																	
<p>C146-P</p> <table border="1"> <tr><td>1</td><td>09N</td><td>MARKER LIGHT</td></tr> <tr><td>2</td><td>09B</td><td>BRAKE LIGHT</td></tr> <tr><td>3</td><td>GND</td><td>GROUND</td></tr> </table> <p>PLUG CONNECTOR AMP 1-480700-0 CBI #B13-1914 PIN TERMINALS 350547-1 CBI #39-7155-2</p> 	1	09N	MARKER LIGHT	2	09B	BRAKE LIGHT	3	GND	GROUND																																																																																										
1	09N	MARKER LIGHT																																																																																																	
2	09B	BRAKE LIGHT																																																																																																	
3	GND	GROUND																																																																																																	
<p>C144-P</p> <table border="1"> <tr><td>1</td><td>18W</td><td>REVERSE SIGNAL</td></tr> <tr><td>2</td><td>GND</td><td>GROUND</td></tr> </table> <p>PLUG CONNECTOR AMP 1-480698-0 CBI #39-7153-9 PIN TERMINALS 350547-1 CBI #39-7155-2</p> 	1	18W	REVERSE SIGNAL	2	GND	GROUND																																																																																													
1	18W	REVERSE SIGNAL																																																																																																	
2	GND	GROUND																																																																																																	
<p>C142-P</p> <table border="1"> <tr><td>1</td><td>18R</td><td>RH TURN SIGNAL</td></tr> <tr><td>2</td><td>GND</td><td>GROUND</td></tr> </table> <p>PLUG CONNECTOR AMP 1-480698-0 CBI #39-7153-9 PIN TERMINALS 350547-1 CBI #39-7155-2</p> 	1	18R	RH TURN SIGNAL	2	GND	GROUND	<p>C103-C</p> <table border="1"> <tr><td>1</td><td>02P</td><td>AUX POWER</td></tr> <tr><td>2</td><td>18W</td><td>REVERSE SIGNAL</td></tr> <tr><td>3</td><td>GND</td><td>GROUND</td></tr> <tr><td>4</td><td>09N</td><td>MARKER LIGHTS</td></tr> <tr><td>5</td><td></td><td>NOT USED</td></tr> <tr><td>6</td><td>18R</td><td>RIGHT TURN SIG</td></tr> <tr><td>7</td><td>03T</td><td>REAR LUGG. LT</td></tr> <tr><td>8</td><td>GND</td><td>GROUND</td></tr> <tr><td>9</td><td>09B</td><td>BRAKE LIGHTS</td></tr> <tr><td>10</td><td>23Y</td><td>WINDOW AJAR</td></tr> <tr><td>11</td><td>18Y</td><td>LEFT TURN SIG</td></tr> <tr><td>12</td><td>07I</td><td>EXIT LIGHTS</td></tr> <tr><td>13</td><td></td><td>NOT USED</td></tr> <tr><td>14</td><td>18Q</td><td>7" LIGHT</td></tr> <tr><td>15</td><td>03E</td><td>REAR DOOR AJAR</td></tr> </table> <p>CAP CONNECTOR AMP 1-480711-0 CBI #39-7155-1 TER. 350547-1 CBI #39-7155-2</p> 	1	02P	AUX POWER	2	18W	REVERSE SIGNAL	3	GND	GROUND	4	09N	MARKER LIGHTS	5		NOT USED	6	18R	RIGHT TURN SIG	7	03T	REAR LUGG. LT	8	GND	GROUND	9	09B	BRAKE LIGHTS	10	23Y	WINDOW AJAR	11	18Y	LEFT TURN SIG	12	07I	EXIT LIGHTS	13		NOT USED	14	18Q	7" LIGHT	15	03E	REAR DOOR AJAR	<p>C103-P</p> <table border="1"> <tr><td>1</td><td>02P</td><td>AUX POWER</td></tr> <tr><td>2</td><td>18W</td><td>BUZZER ALARM</td></tr> <tr><td>3</td><td>GND</td><td>GROUND</td></tr> <tr><td>4</td><td>09N</td><td>MARKER LIGHTS</td></tr> <tr><td>5</td><td></td><td>NOT USED</td></tr> <tr><td>6</td><td>18R</td><td>RIGHT TURN SIG</td></tr> <tr><td>7</td><td>03T</td><td>REAR LUGG. LT</td></tr> <tr><td>8</td><td>GND</td><td>GROUND</td></tr> <tr><td>9</td><td>09B</td><td>BRAKE LIGHTS</td></tr> <tr><td>10</td><td>23Y</td><td>WINDOW AJAR</td></tr> <tr><td>11</td><td>18Y</td><td>LEFT TURN SIG</td></tr> <tr><td>12</td><td>07I</td><td>EXIT LIGHTS</td></tr> <tr><td>13</td><td></td><td>NOT USED</td></tr> <tr><td>14</td><td>18Q</td><td>7" LIGHT</td></tr> <tr><td>15</td><td>03E</td><td>REAR DOOR AJAR</td></tr> </table> <p>PLUG CONNECTOR AMP 1-480710-0 CBI #39-7154-8 TER 350550-1 CBI #39-7155-3</p> 	1	02P	AUX POWER	2	18W	BUZZER ALARM	3	GND	GROUND	4	09N	MARKER LIGHTS	5		NOT USED	6	18R	RIGHT TURN SIG	7	03T	REAR LUGG. LT	8	GND	GROUND	9	09B	BRAKE LIGHTS	10	23Y	WINDOW AJAR	11	18Y	LEFT TURN SIG	12	07I	EXIT LIGHTS	13		NOT USED	14	18Q	7" LIGHT	15	03E	REAR DOOR AJAR	
1	18R	RH TURN SIGNAL																																																																																																	
2	GND	GROUND																																																																																																	
1	02P	AUX POWER																																																																																																	
2	18W	REVERSE SIGNAL																																																																																																	
3	GND	GROUND																																																																																																	
4	09N	MARKER LIGHTS																																																																																																	
5		NOT USED																																																																																																	
6	18R	RIGHT TURN SIG																																																																																																	
7	03T	REAR LUGG. LT																																																																																																	
8	GND	GROUND																																																																																																	
9	09B	BRAKE LIGHTS																																																																																																	
10	23Y	WINDOW AJAR																																																																																																	
11	18Y	LEFT TURN SIG																																																																																																	
12	07I	EXIT LIGHTS																																																																																																	
13		NOT USED																																																																																																	
14	18Q	7" LIGHT																																																																																																	
15	03E	REAR DOOR AJAR																																																																																																	
1	02P	AUX POWER																																																																																																	
2	18W	BUZZER ALARM																																																																																																	
3	GND	GROUND																																																																																																	
4	09N	MARKER LIGHTS																																																																																																	
5		NOT USED																																																																																																	
6	18R	RIGHT TURN SIG																																																																																																	
7	03T	REAR LUGG. LT																																																																																																	
8	GND	GROUND																																																																																																	
9	09B	BRAKE LIGHTS																																																																																																	
10	23Y	WINDOW AJAR																																																																																																	
11	18Y	LEFT TURN SIG																																																																																																	
12	07I	EXIT LIGHTS																																																																																																	
13		NOT USED																																																																																																	
14	18Q	7" LIGHT																																																																																																	
15	03E	REAR DOOR AJAR																																																																																																	
<p>C141-PW</p> <table border="1"> <tr><td>A</td><td>09N</td><td>MARKER LIGHT</td></tr> <tr><td>B</td><td>18R</td><td>RH TURN SIGNAL</td></tr> <tr><td>C</td><td>GND</td><td>GROUND</td></tr> </table> <p>MALE CONNECTOR 12020829 CBI #39-7214-5 MALE TERMINAL 12124582-L CBI #39-7096-9 SEAL 12015323-V CBI #39-7098-5</p> 	A	09N	MARKER LIGHT	B	18R	RH TURN SIGNAL	C	GND	GROUND																																																																																										
A	09N	MARKER LIGHT																																																																																																	
B	18R	RH TURN SIGNAL																																																																																																	
C	GND	GROUND																																																																																																	
<p>C068F</p> <table border="1"> <tr><td>03AE</td><td>REAR DOOR AJAR</td></tr> </table> <p>SPEAKER TERMINAL MOLEX TERM. TAPE QV-DIS FEM F/INS 16-1423 CBI #39-4426-1</p> 	03AE	REAR DOOR AJAR																																																																																																	
03AE	REAR DOOR AJAR																																																																																																		



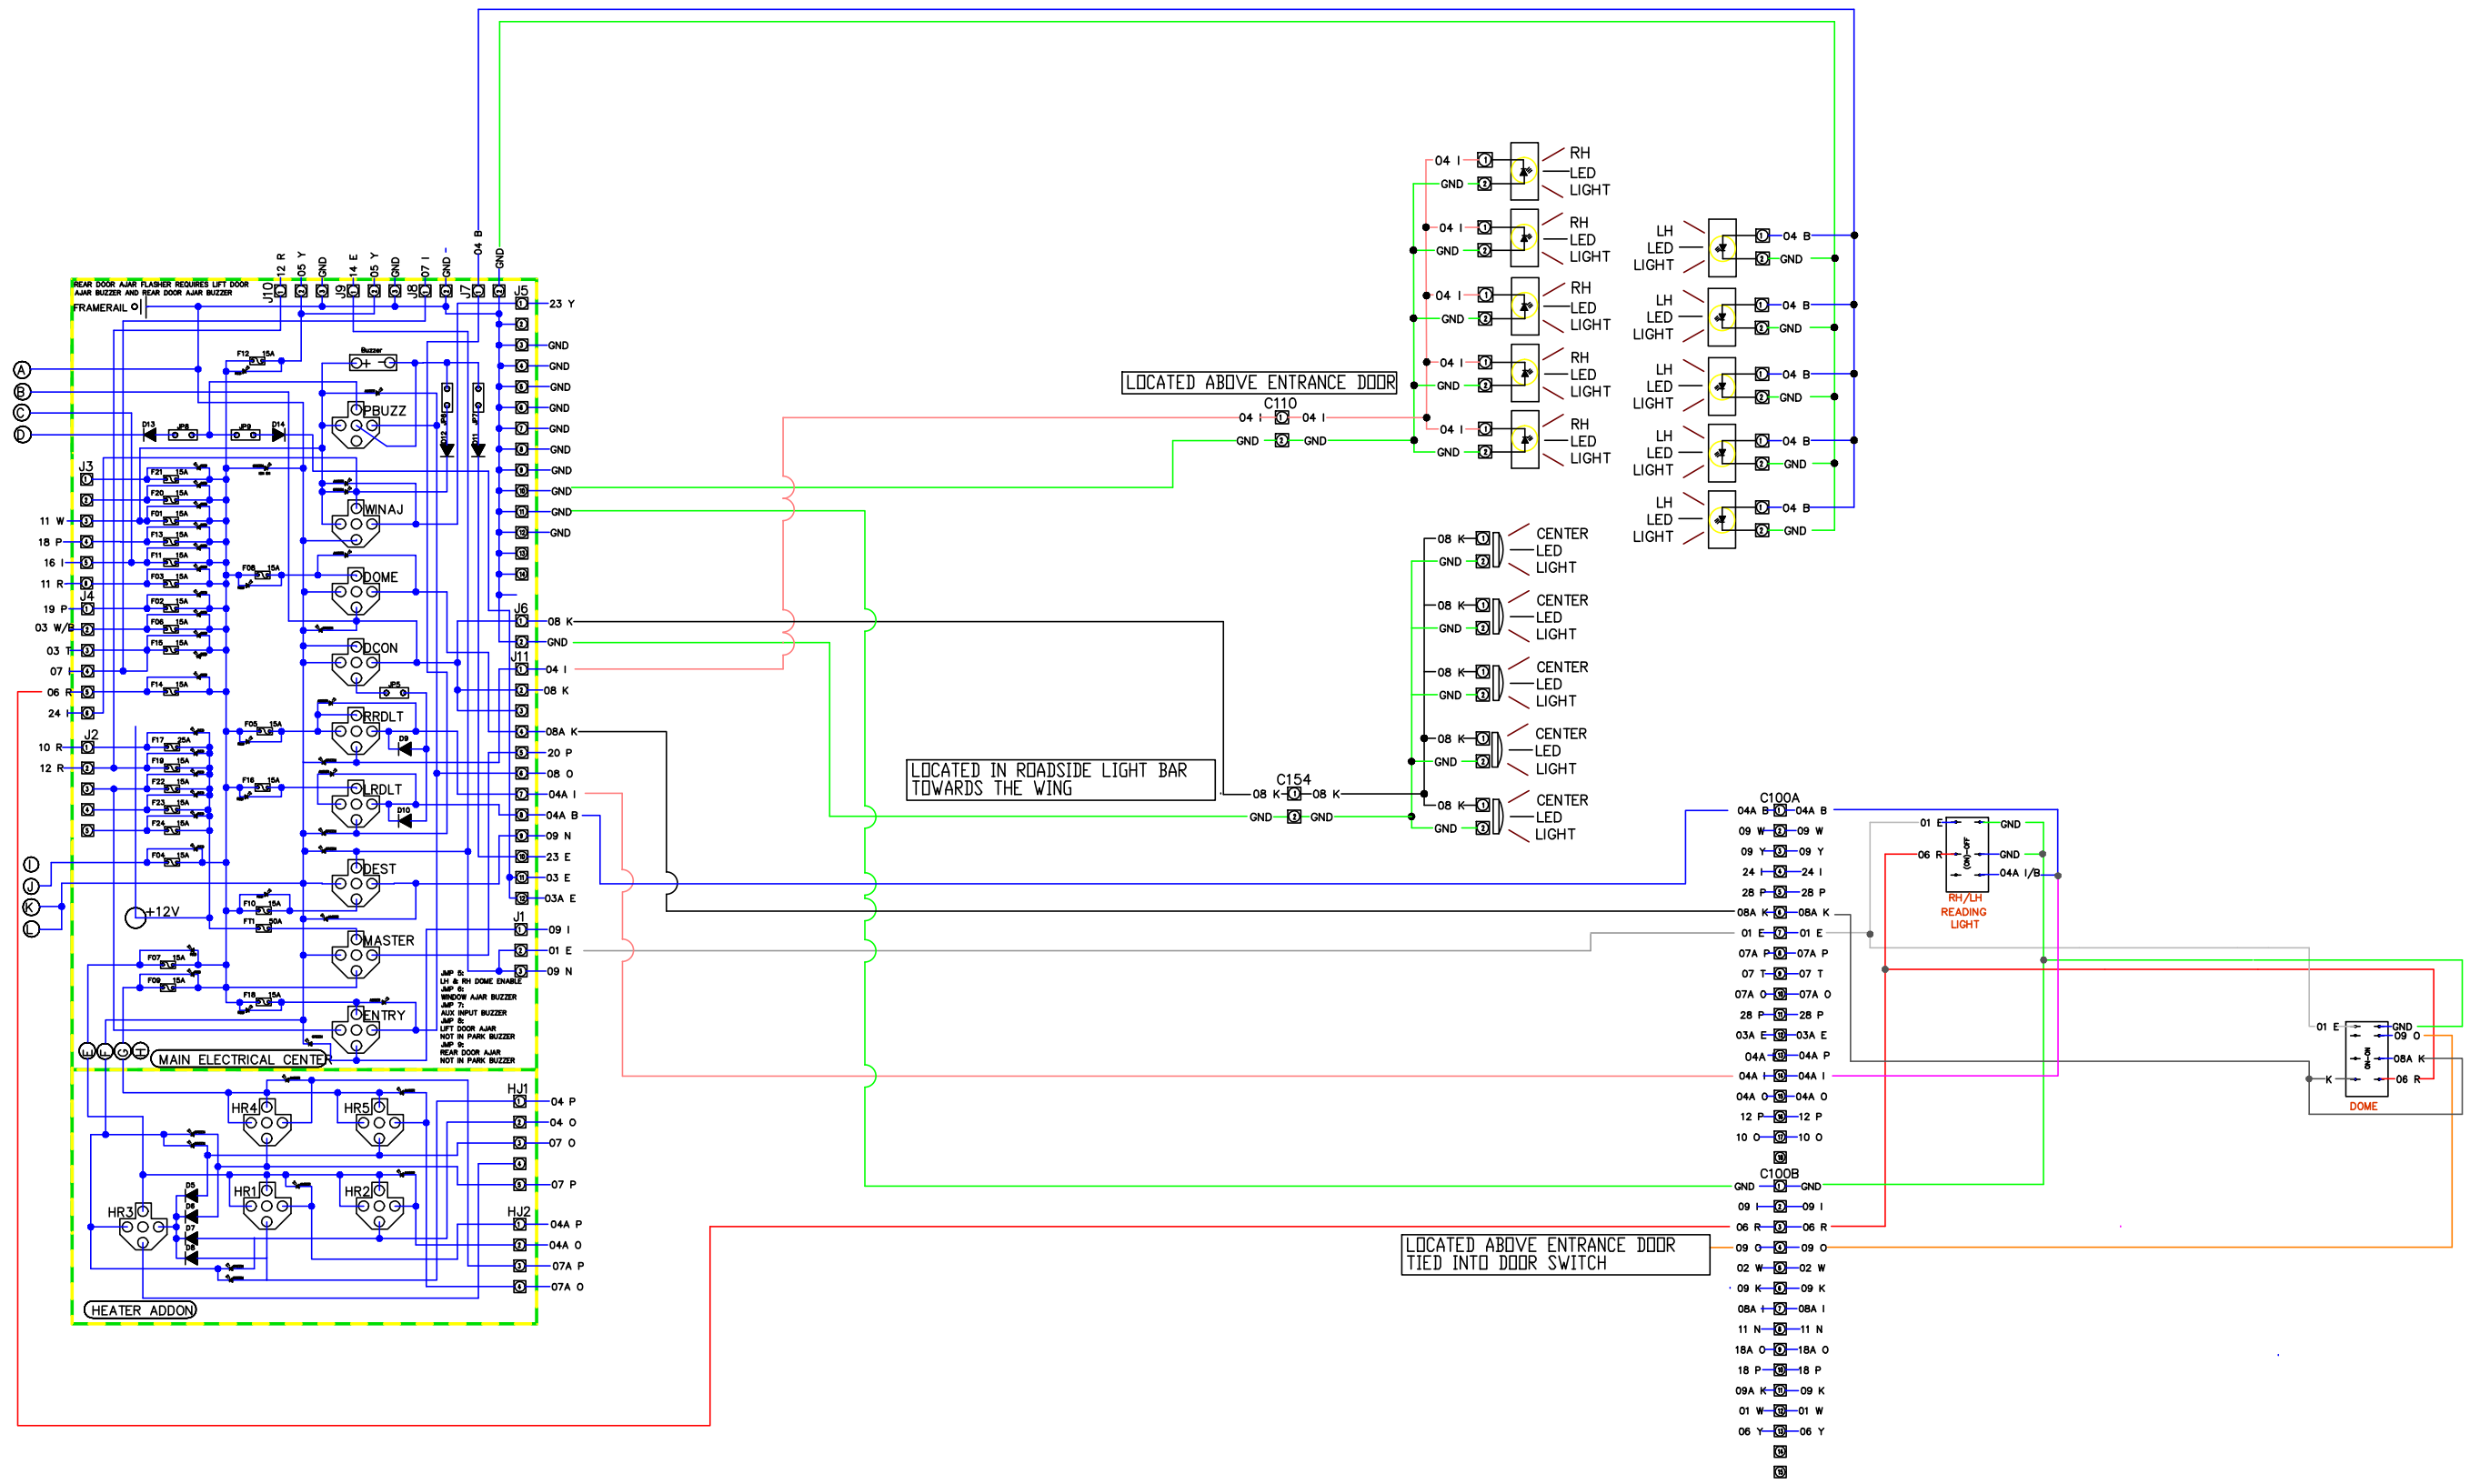


INTERIOR LIGHTING

DATE		ERN	DESCRIPTION OF CHANGES	BY	DATE	ERN	DESCRIPTION OF CHANGES	BY	 CHAMPION BUS INC. a TEKON company		APPROVED BY: DD P/M: M DO NOT SCALE: N/A SCALE: N/A	ERN#: LB DRAWN BY: PDOT	TITLE: ASBUILT FORD ANALOG MODEL: FORD	REFERENCE DWG: FORD DWG. NO.: SHEET 1 OF 1 RELEASE DATE: 5/11/11
------	--	-----	------------------------	----	------	-----	------------------------	----	--	--	--	--	---	---

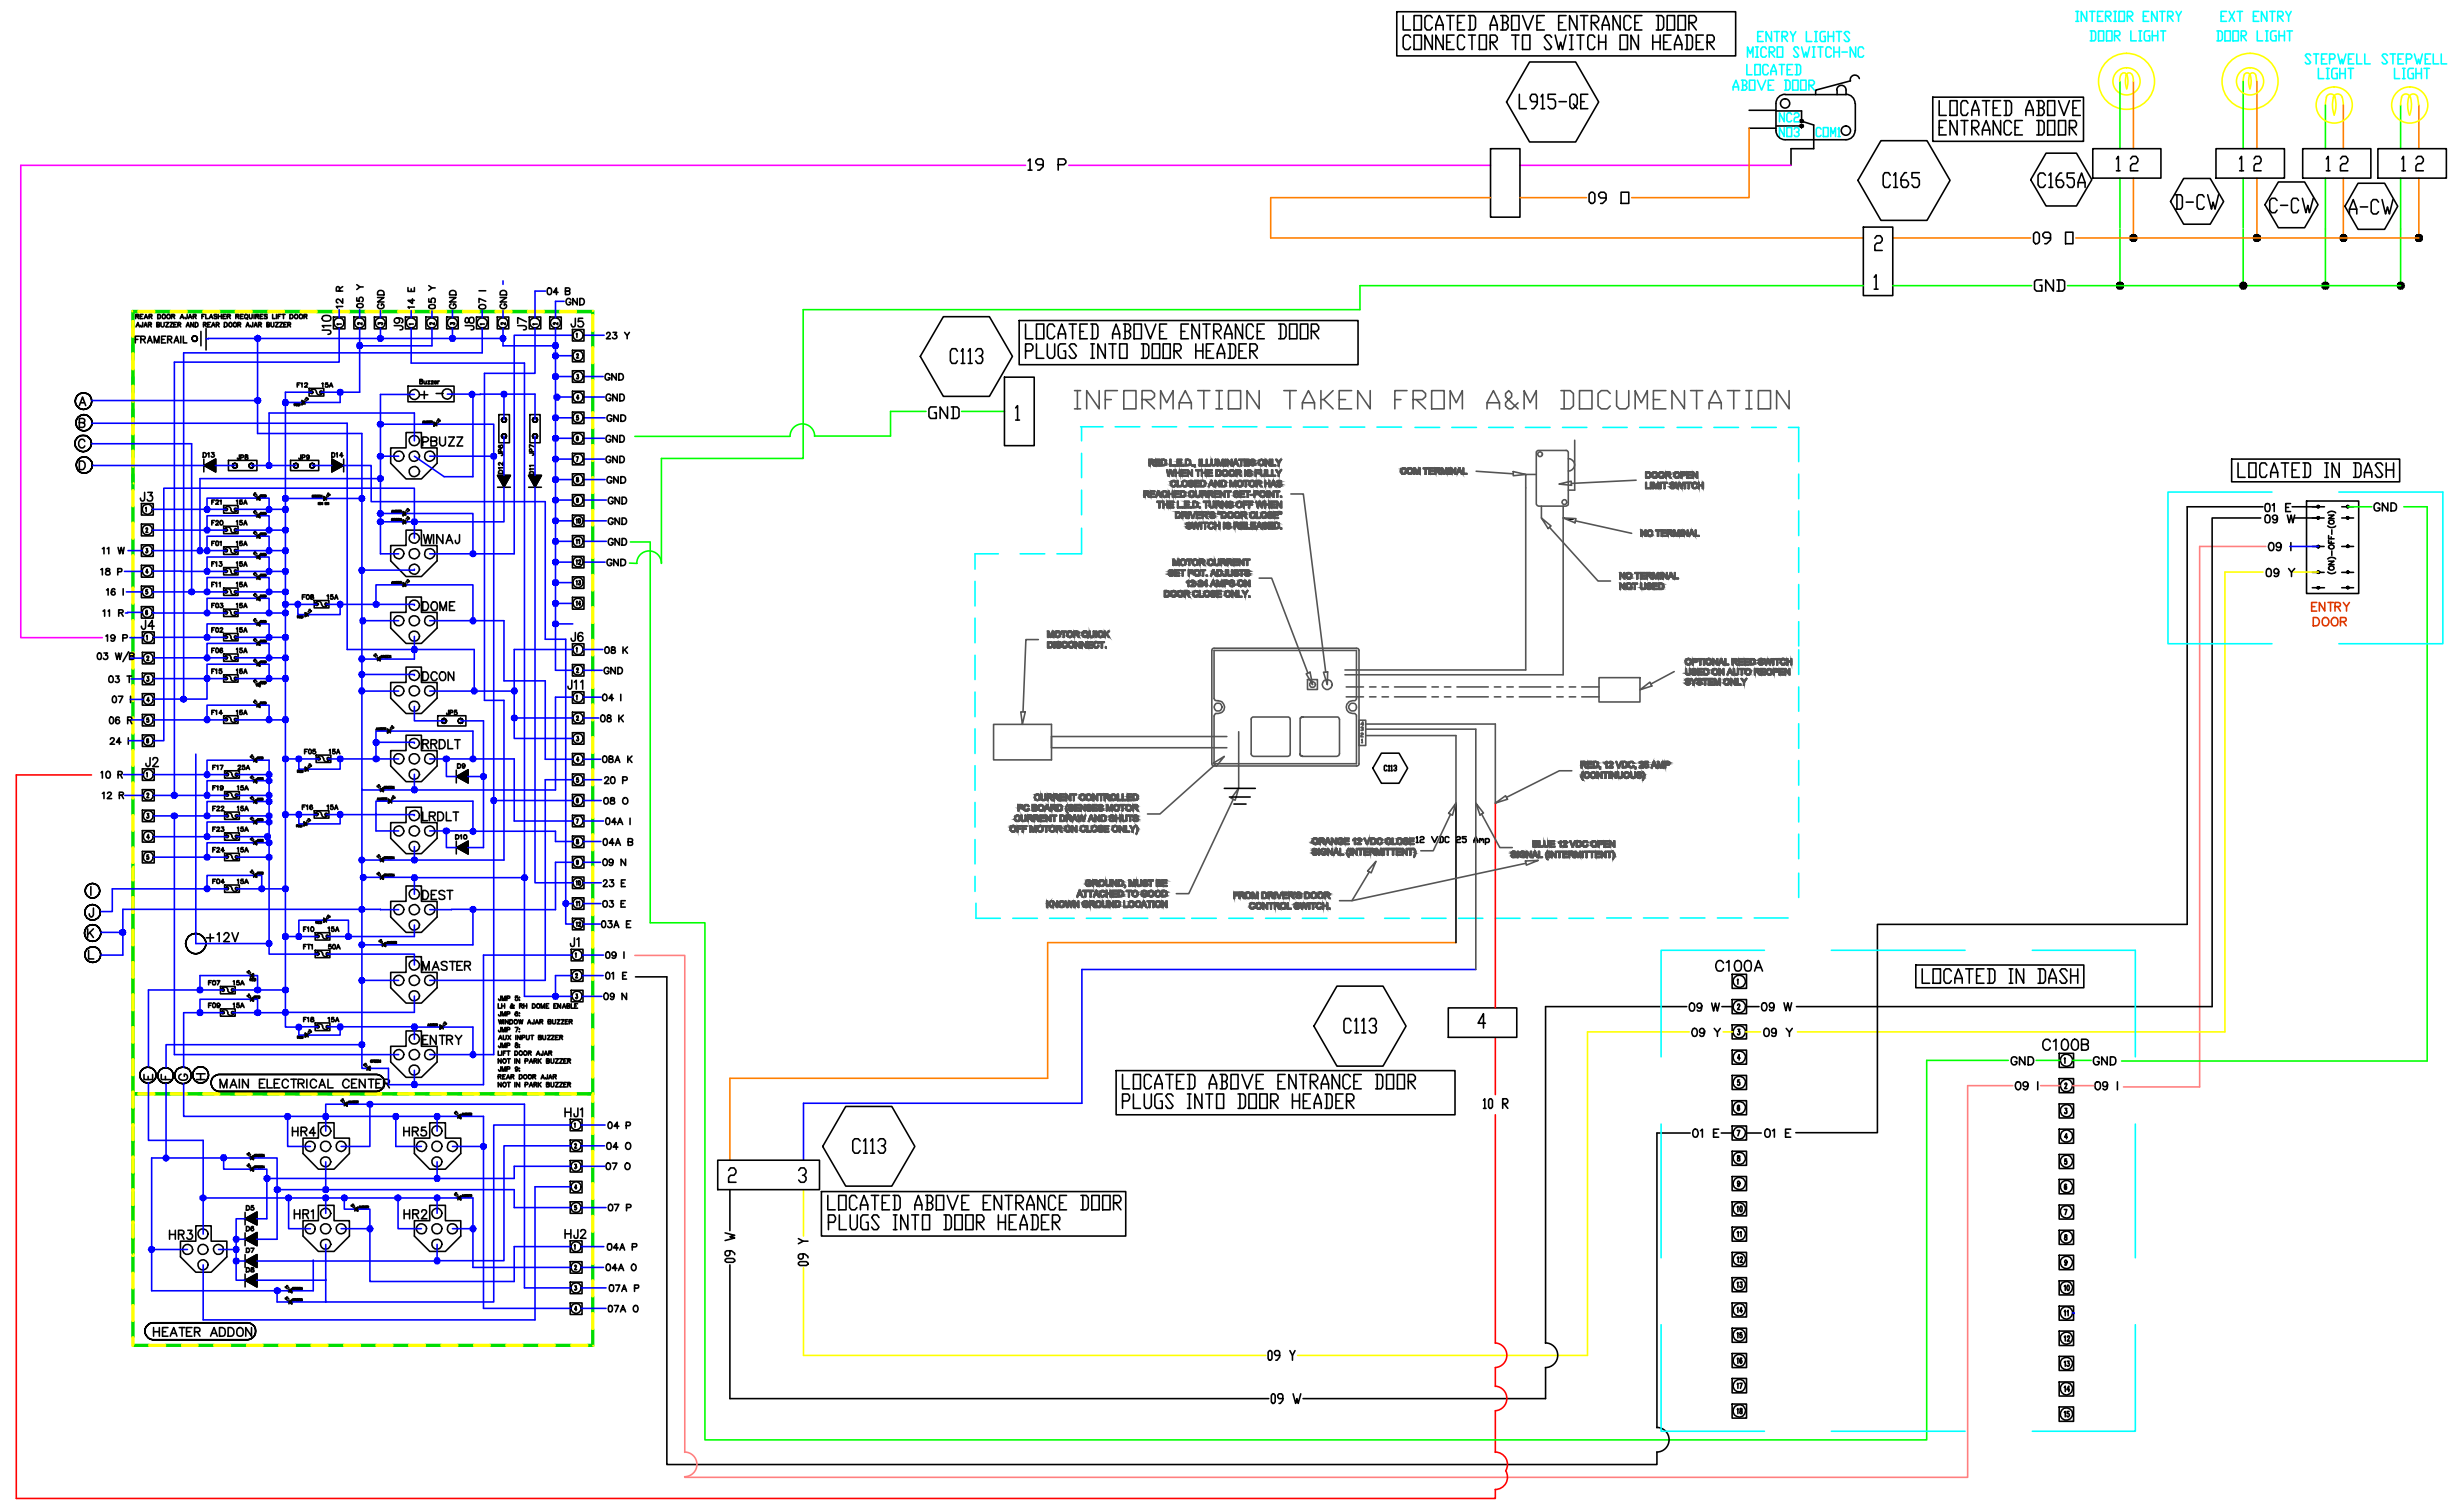


ENTRANCE DOOR SYSTEM

DATE		ERN	DESCRIPTION OF CHANGES	BY	DATE	ERN	DESCRIPTION OF CHANGES	BY	 APPROVED BY: DD P/M: M DO NOT SCALE: N/A SCALE: N/A	ERN#: LB DRAWN BY: PDOT CUSTOMER: FORD	TITLE: ASBUILT FORD ANALOG MODEL: FORD	REFERENCE DWG: FORD DWG. NO.: SHEET 1 OF 1 RELEASE DATE: 5/11/11 CBI UNIT NUMBERS:
------	--	-----	------------------------	----	------	-----	------------------------	----	---	--	---	--

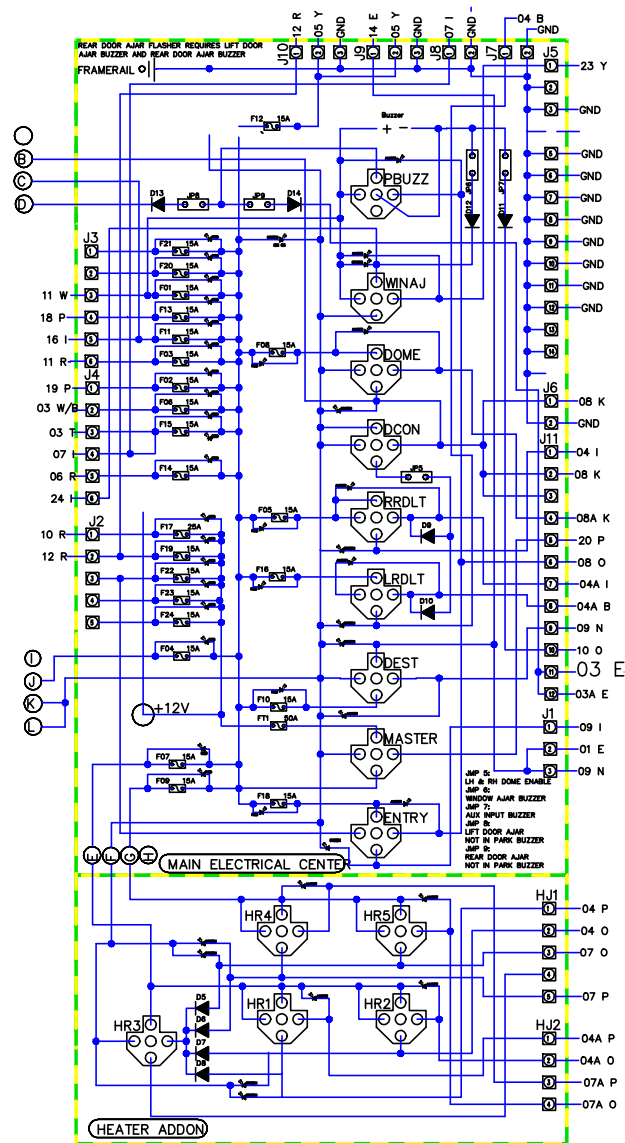

15

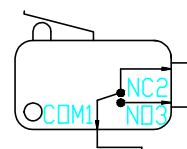

03 E

REAR DOOR
JAM SWITCH-NO

LOCATED NEAR REAR DOOR


GND

LOCATED REAR DRIVER'S CORNER
BELOW FLOOR OF BUS

DATE	ERN	DESCRIPTION OF CHANGES	BY	DATE	ERN	DESCRIPTION OF CHANGES	BY



APPROVED BY: DD	ERN#:	TITLE: ASBUILT FORD ANALOG	REFERENCE DWG: FORD
P/ME: M	DO NOT SCALE SCALE: N/A	DRAWN BY/CUSTOMER: LB PDDT	MODEL: FORD
DWG. NO.:	RELEASE DATE: 5/11/11	SHEET 1 OF	UNIT NUMBERS:

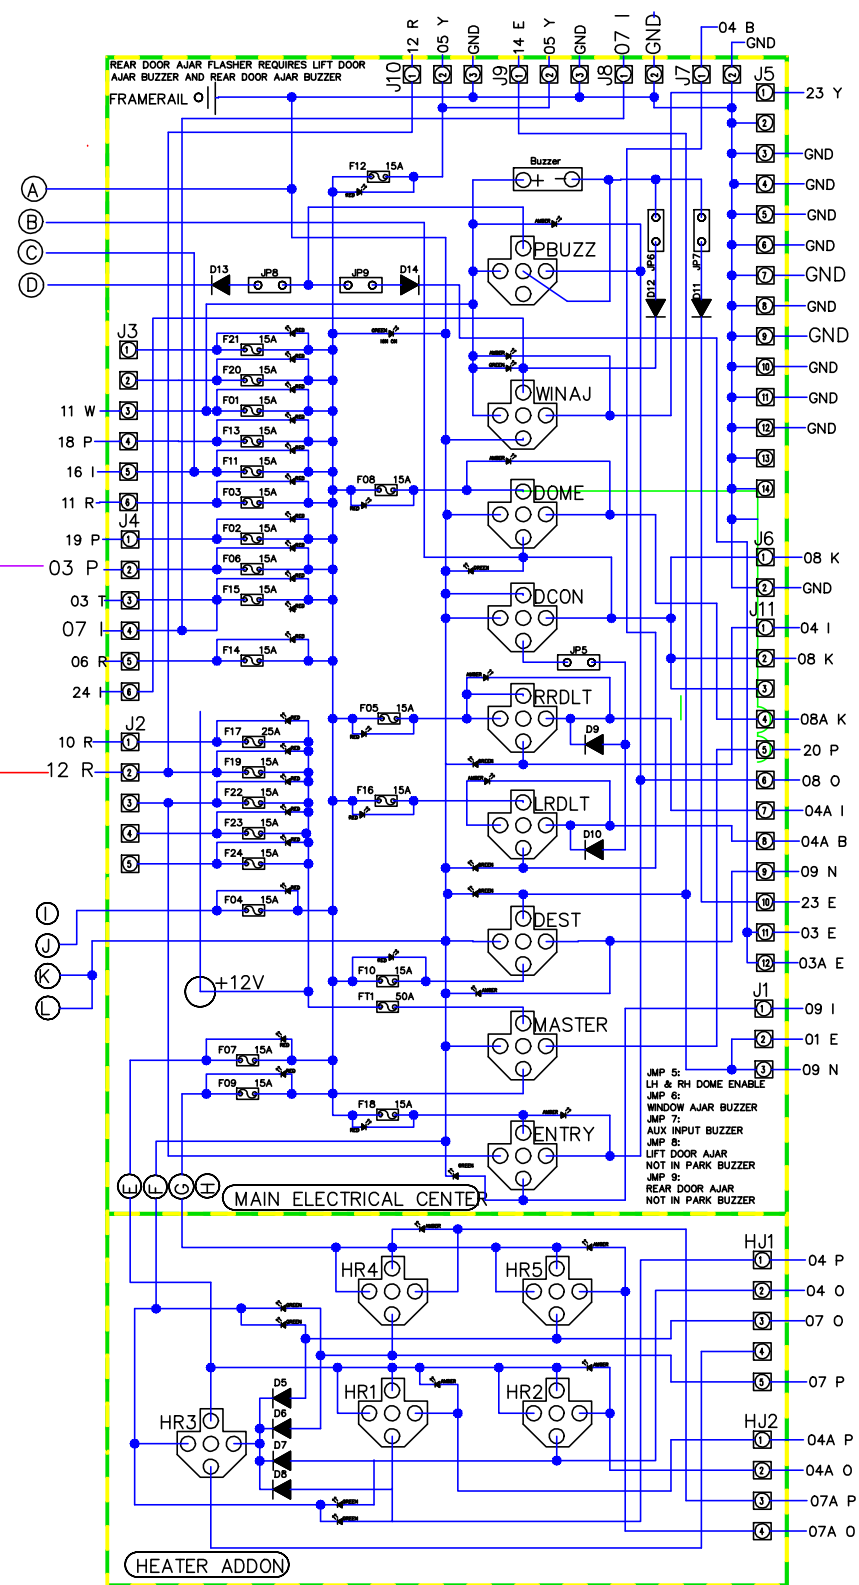

- RADIO
- R - +12V IGNITION / SWITCHED
 - Y - +12V BATTERY / CONSTANT
 - K - CHASSIS GROUND
 - NO CONNECTION
 - W/K - LF SPEAKER (+)
 - W/K - LF SPEAKER (-)
 - E - RF SPEAKER (+)
 - E/K - RF SPEAKER (-)
 - P - RR SPEAKER (+)
 - P/K - RR SPEAKER (-)
 - G - LR SPEAKER (+)
 - G/K - LR SPEAKER (-)
- C137
 20 P
 12 R
- DEM CHASSIS
 IGN TIE-IN POINT


TO DASH A/C SWITCH

IGNITION CONTROLLED CIRCUITS

REV	DATE	ERN	DESCRIPTION OF CHANGES	BY	DATE	ERN	DESCRIPTION OF CHANGES	BY

APPROVED BY:	ERN#:	TITLE:	REFERENCE DWG:
DD		ASBUILT FORD ANALOG	FORD
P/ME:	DO NOT SCALE:	DRAWN BY:	MODEL:
M	SCALE: N/A	LB PDOT	FORD
DWG. NO.:	RELEASE DATE:	CBI UNIT NUMBERS:	
SHEET 1 OF 1	5/11/11		



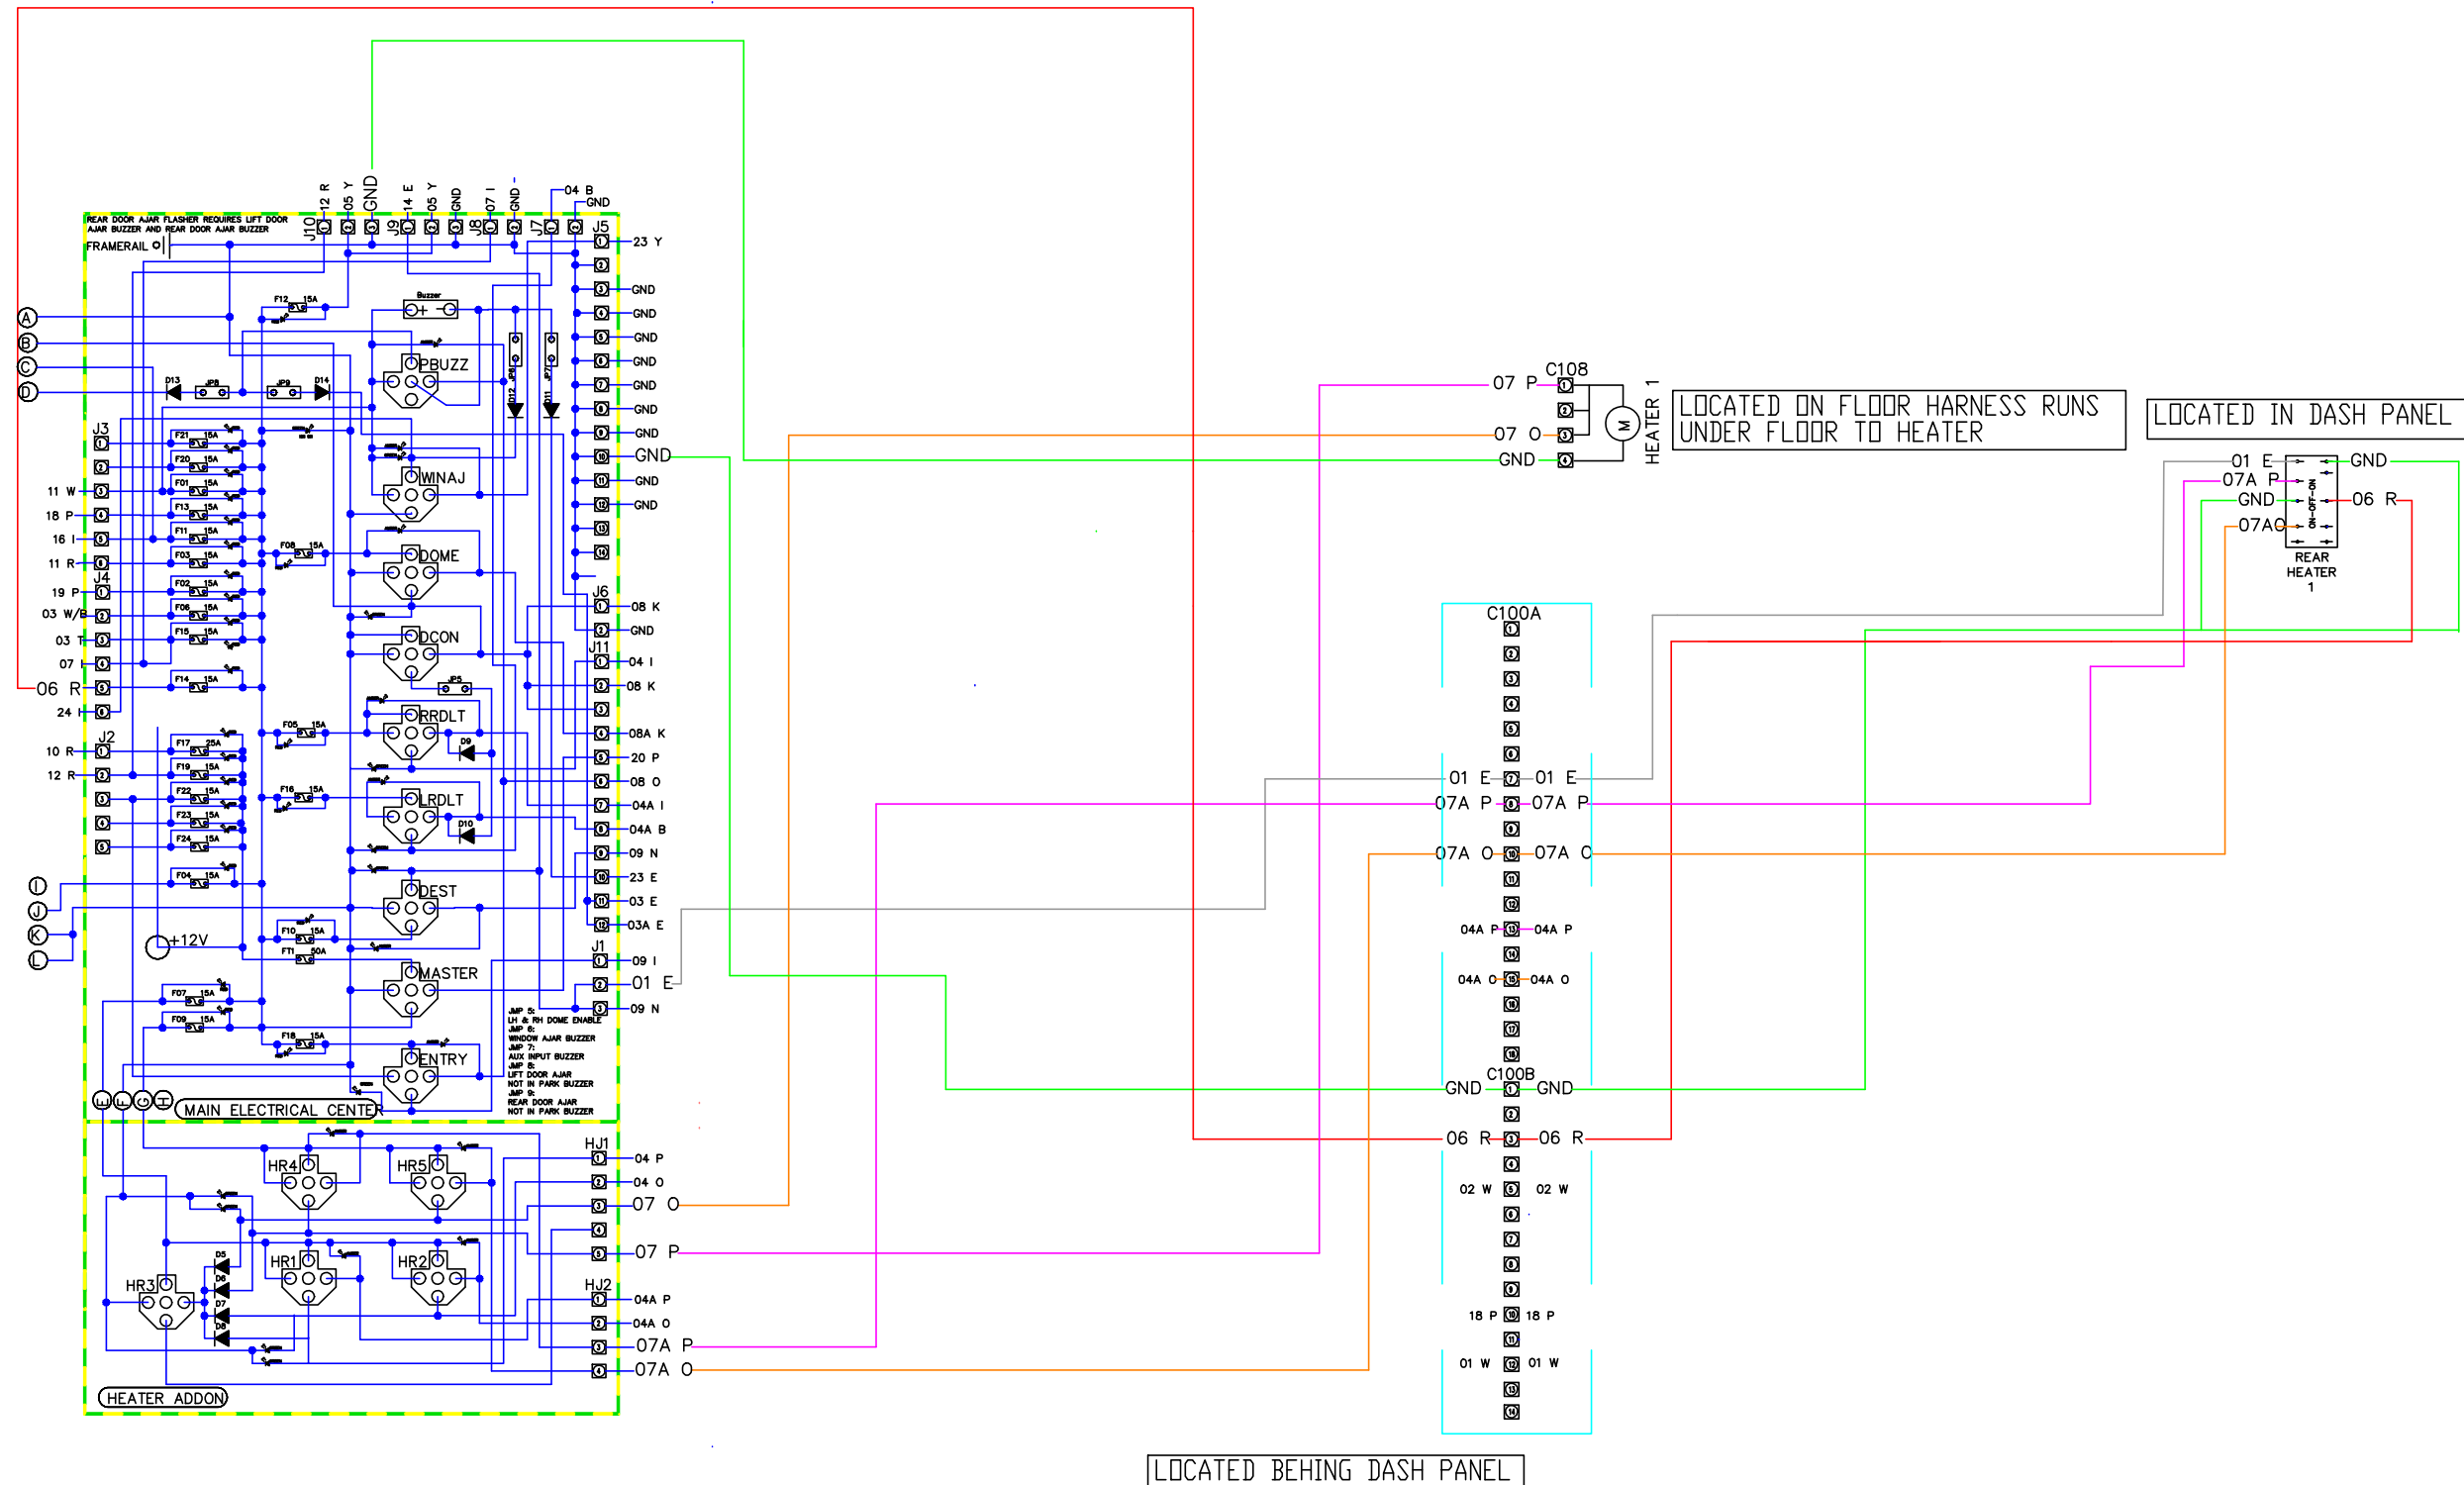

AUXILARY HEATING SYSTEM

DATE		ERIN		DESCRIPTION OF CHANGES		BY		DATE		ERIN		DESCRIPTION OF CHANGES		BY		DATE		ERIN		DESCRIPTION OF CHANGES		BY	



CHAMPION
BUS INC.
— a **TEKNO** company —

APPROVED BY: DD
P/IE: M
DO NOT SCALE: N/A
SCALE: N/A


DRAWN BY: CUSTOMER: LB
PDDT

MODEL: FORD

RELEASE DATE: 5/11/11

REFERENCE DWG: FORD

DWG. NO. SHEET 1 OF 1

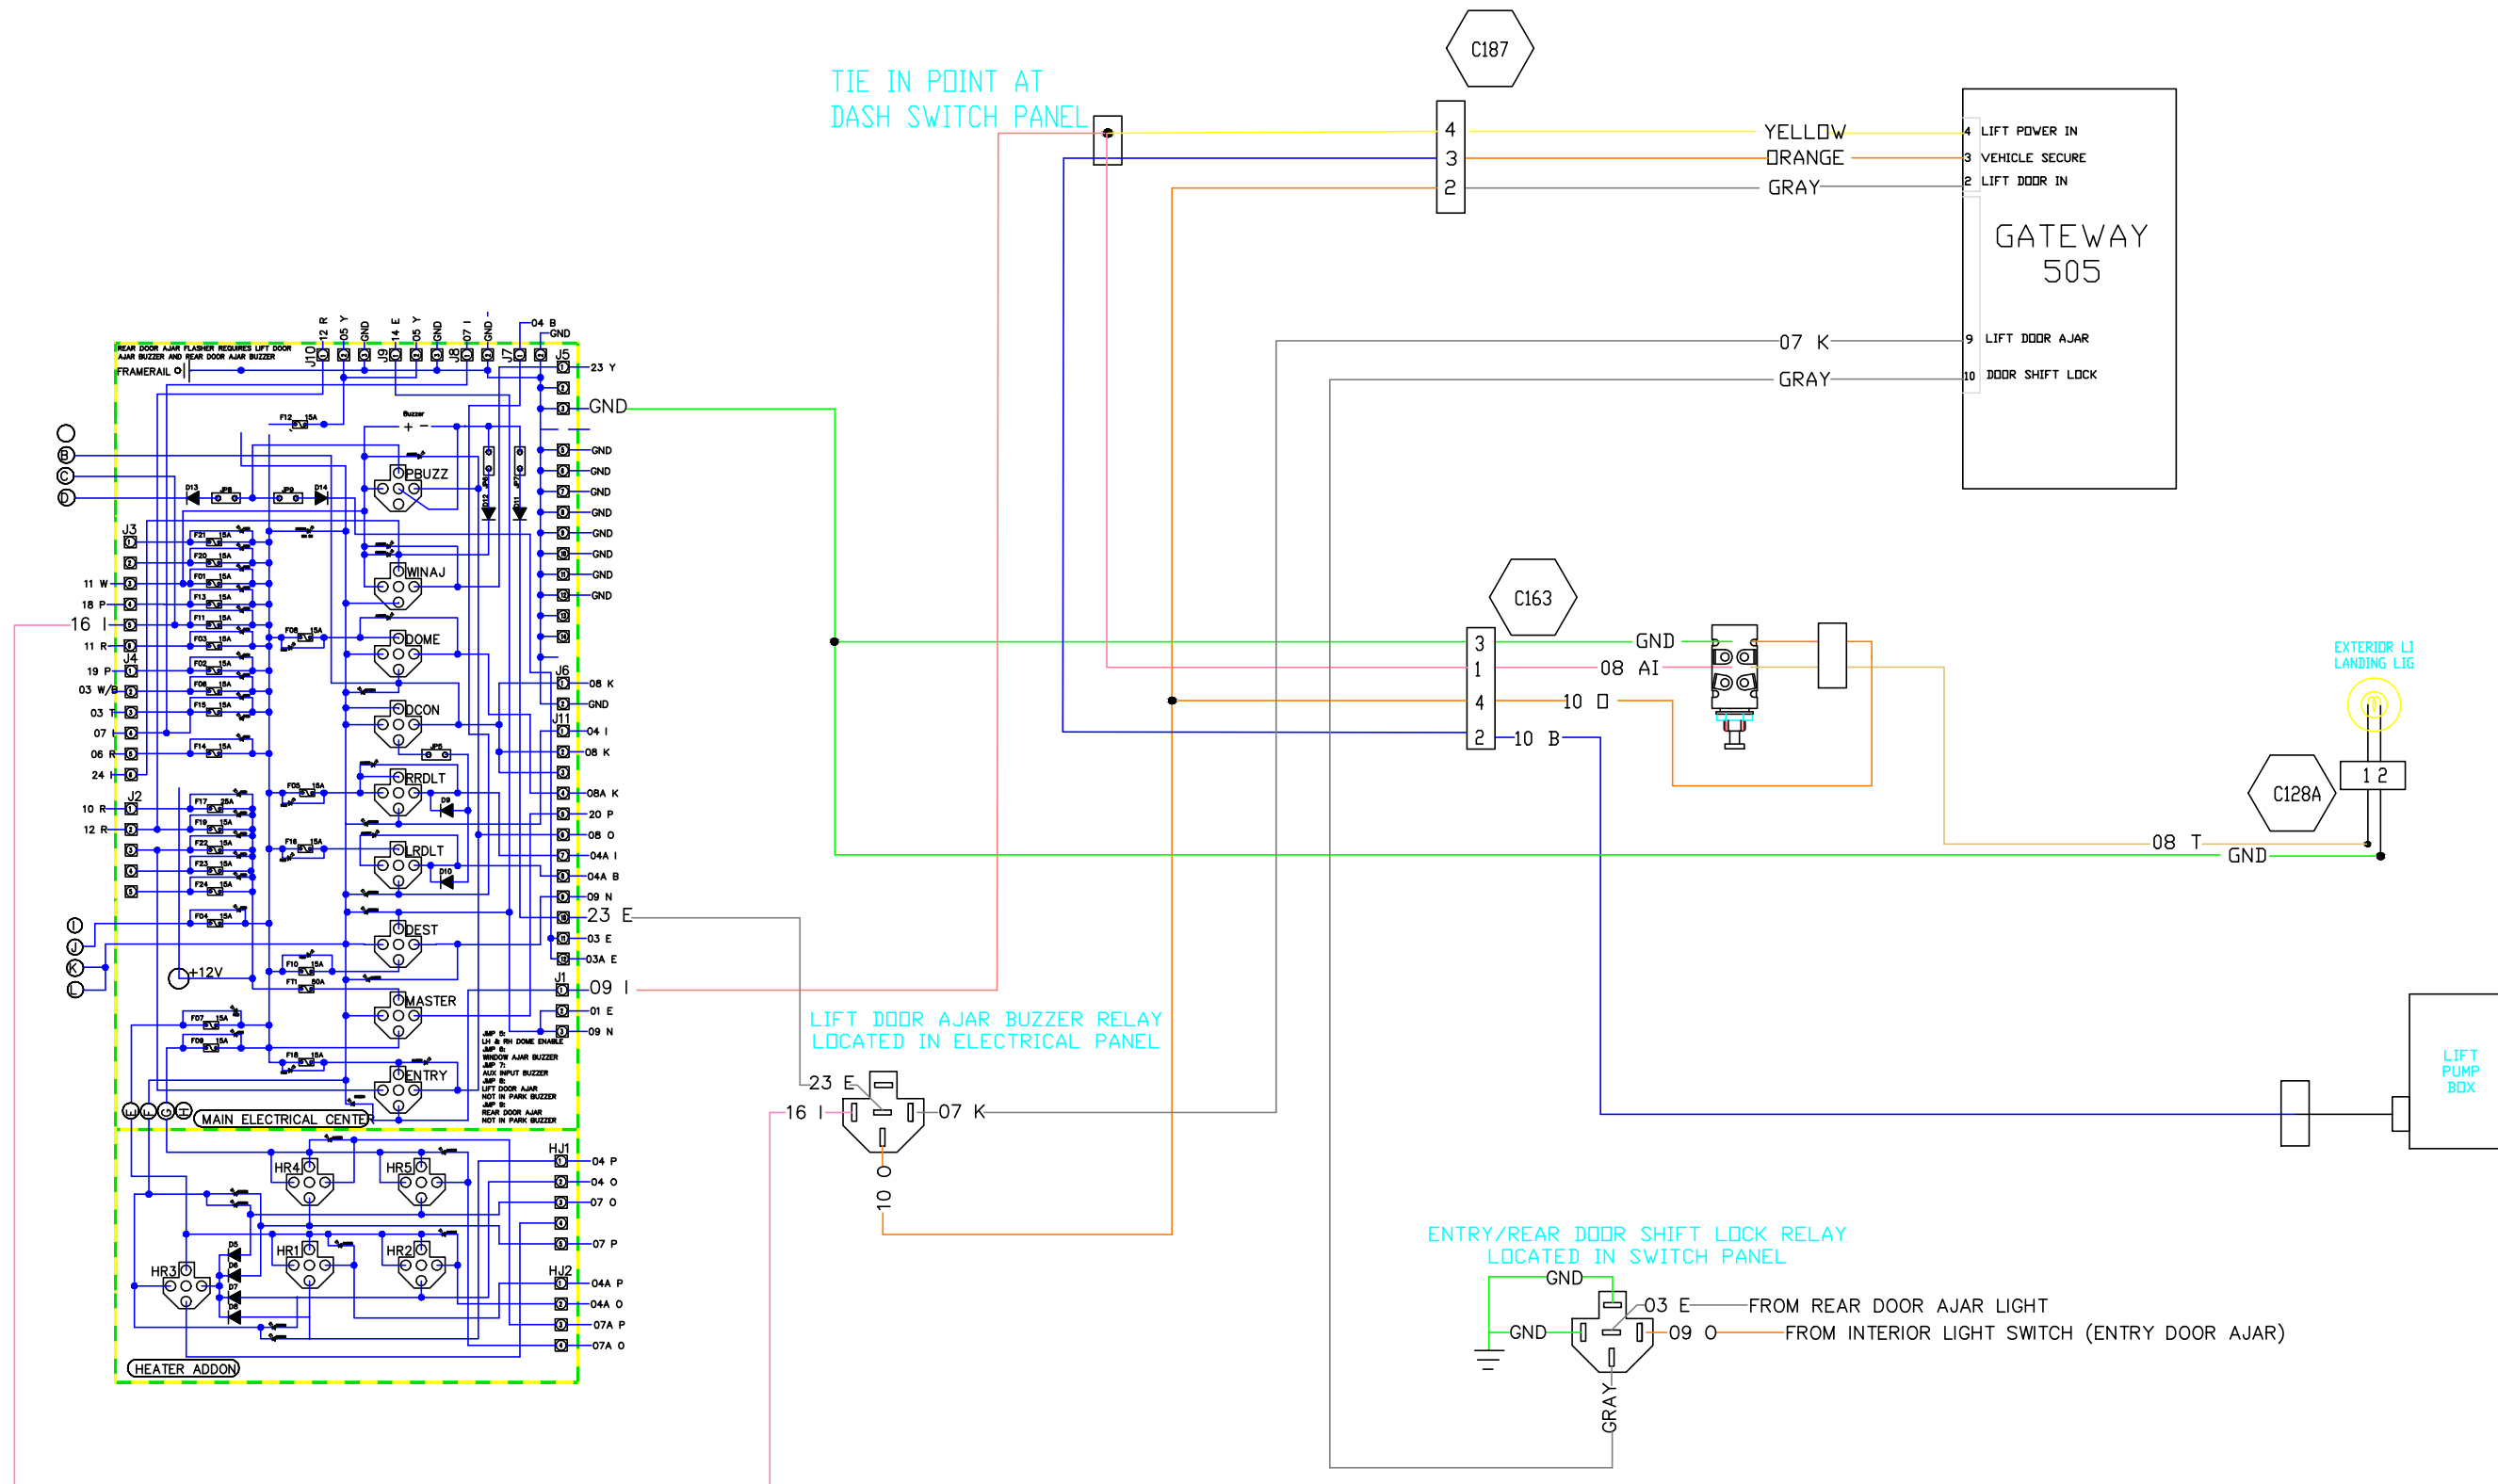

TIE IN POINT AT DASH SWITCH PANEL

LIFT DOOR AJAR BUZZER RELAY LOCATED IN ELECTRICAL PANEL

ENTRY/REAR DOOR SHIFT LOCK RELAY LOCATED IN SWITCH PANEL

LIFT SYSTEM

REV	DATE	ERN	DESCRIPTION OF CHANGES	BY	DATE	ERN	DESCRIPTION OF CHANGES	BY




CHAMPION
BUS INC.
— a TECUMSEH company —

APPROVED BY: DD
P/M: M
DO NOT SCALE: N/A
SCALE: N/A

ERN#: LB
DRAWN BY: PDDT


TITLE: ASBUILTS FORD ANALOG
MODEL: FORD

REFERENCE DWG: FORD
DWG. NO.:
SHEET 1 OF 1
RELEASE DATE: 5/11/11
CBI UNIT NUMBERS:

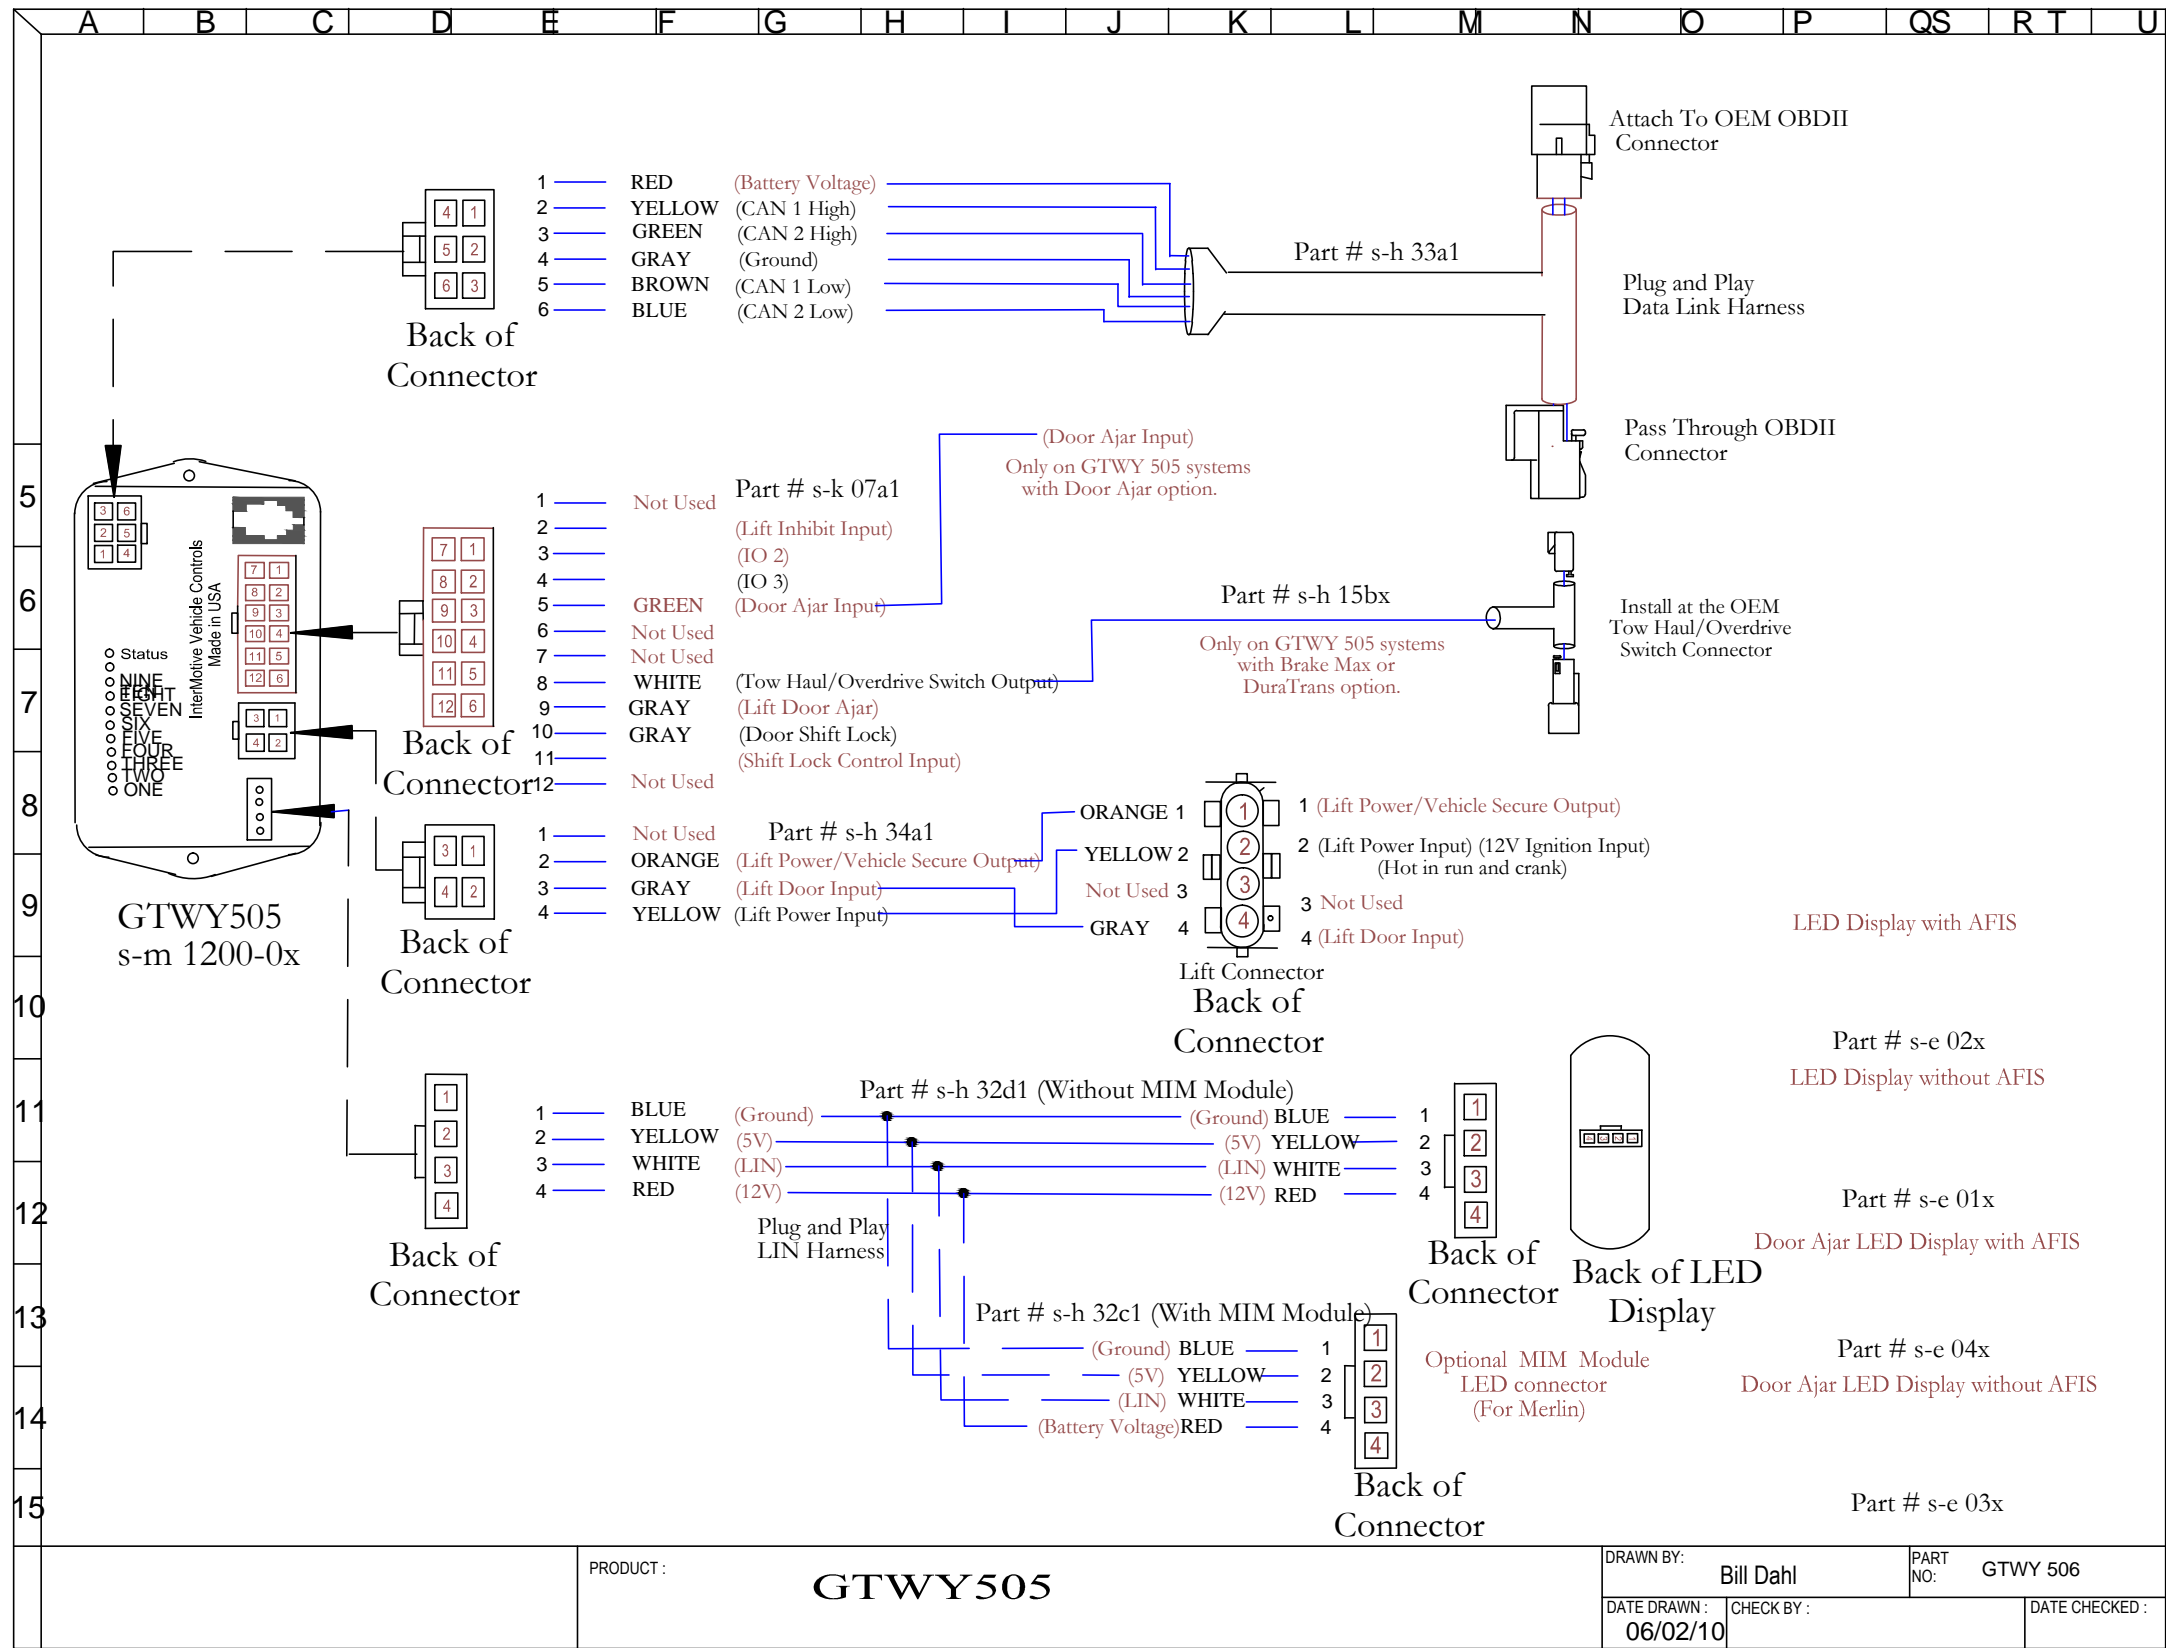

PRODUCT: GTWY505		DRAWN BY: Bill Dahl	PART NO: GTWY 506
DATE DRAWN: 06/02/10	CHECK BY:	DATE CHECKED:	

LIFT SYSTEM

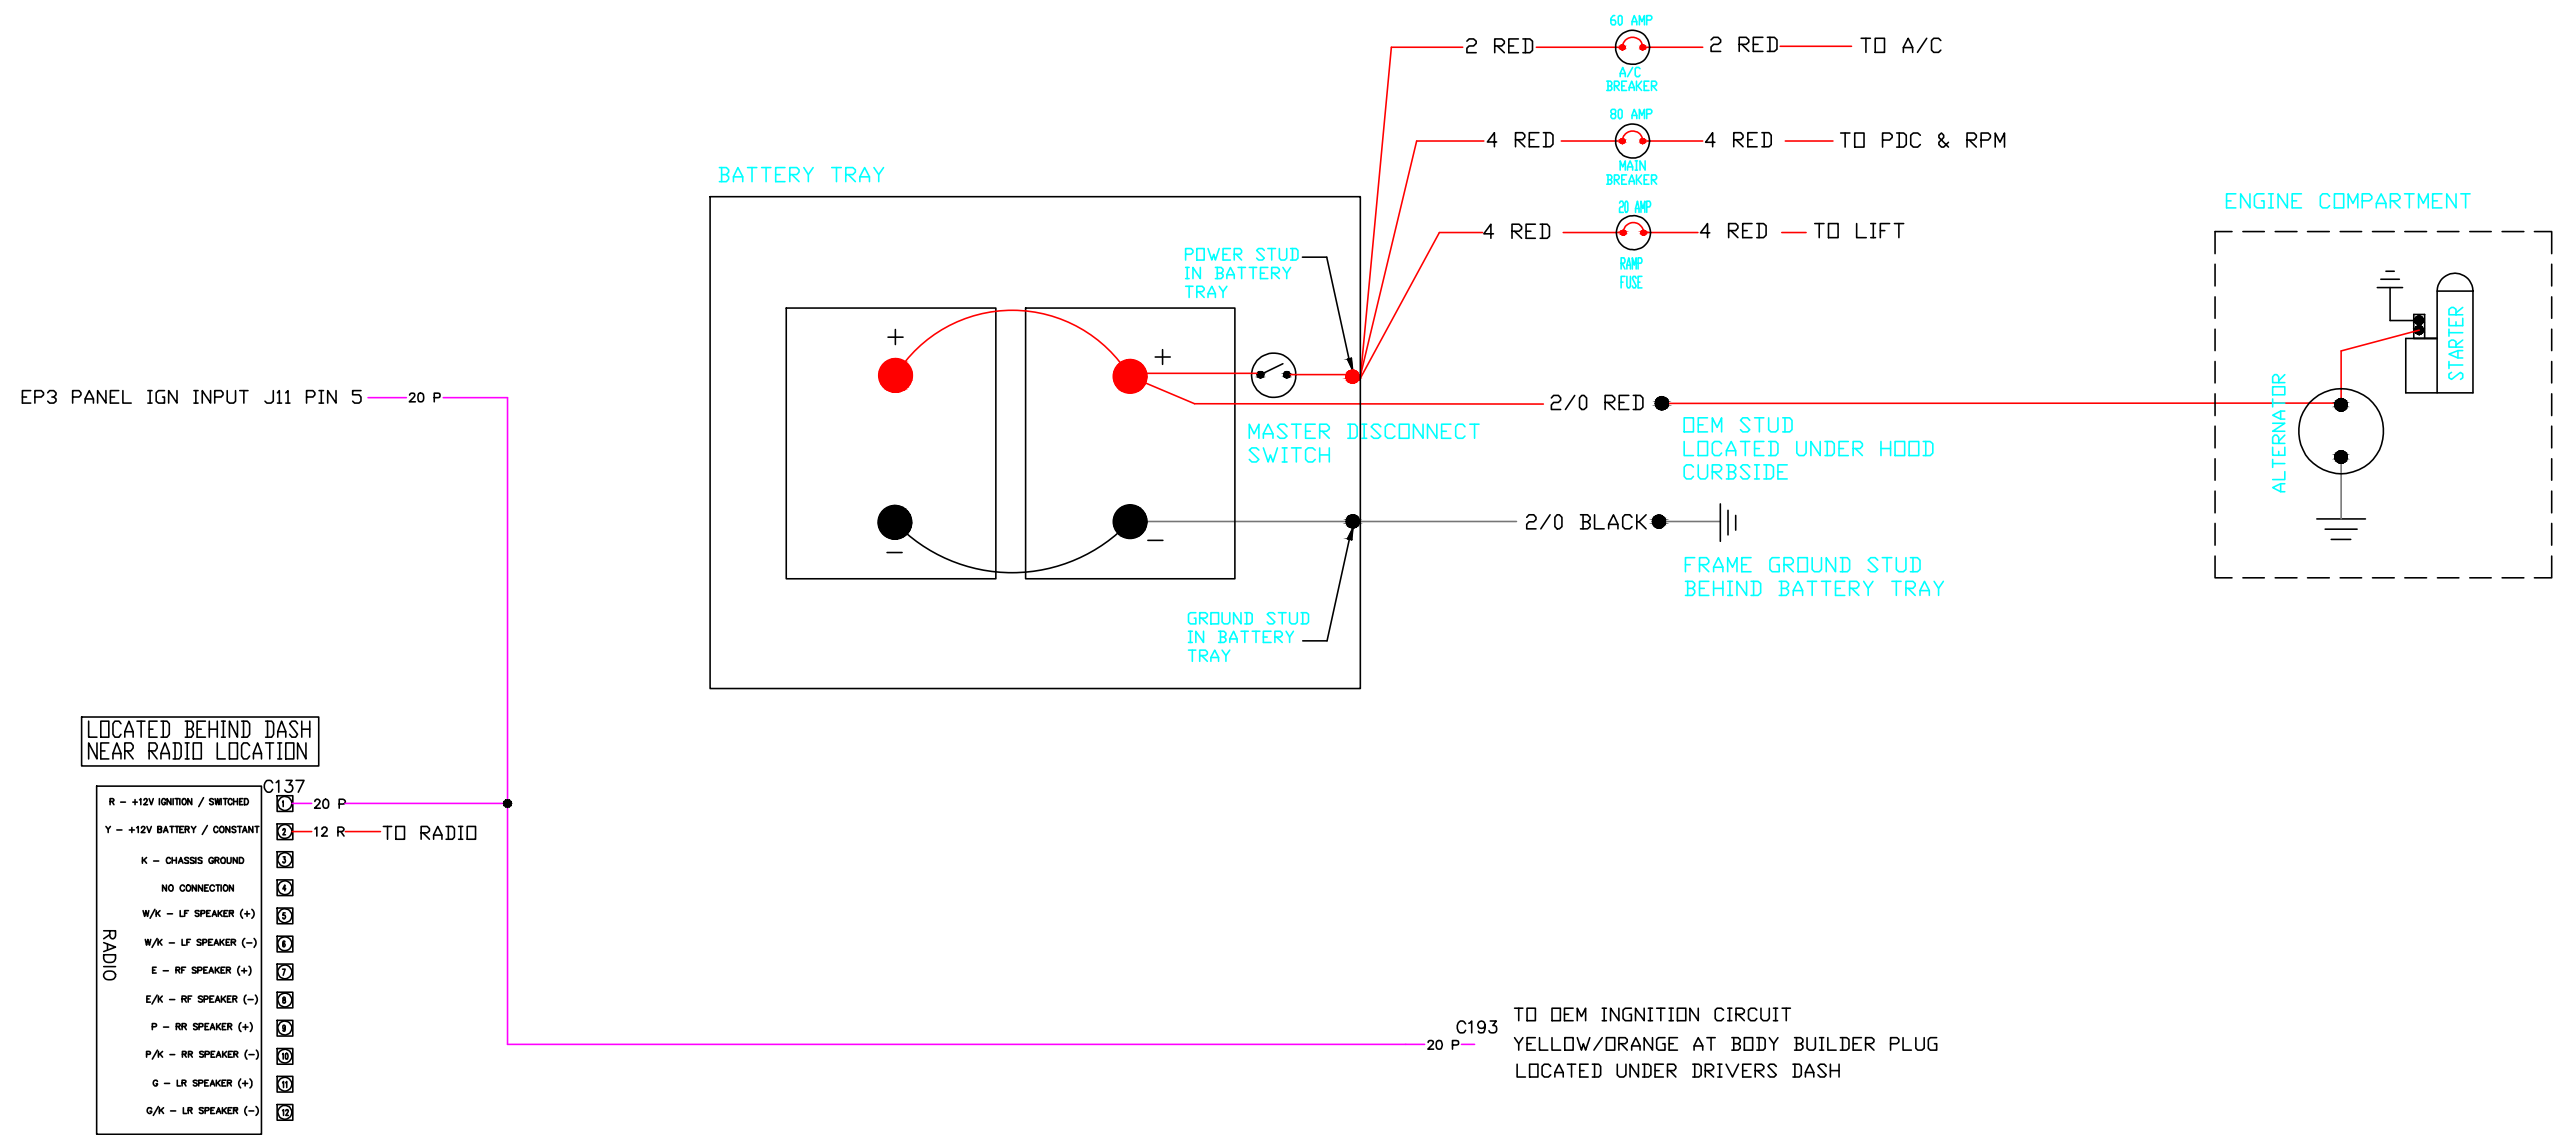

MAIN POWER CONNECTIONS

												APPROVED BY: DD P/IE: M DO NOT SCALE: N/A SCALE: N/A	ERN#: LB DRAWN BY: PDOT	TITLE: ASBUILT FORD ANALOG MODEL: FORD	REFERENCE DWG: FORD DWG. NO.: SHEET 1 OF 1	RELEASE DATE: 5/11/11 CBI UNIT NUMBERS:
R	DATE	ERN	DESCRIPTION OF CHANGES	BY	R	DATE	ERN	DESCRIPTION OF CHANGES	BY							


C103, C104, C105,
 C108, C109, C124,
 C127, C132, C133,
 C134, C138, C167,
 C174, MAIN, MAIN-2,
 MAIN-3

LEFT OVERHEAD HARNESS

DOME LIGHTS HARNESS


FRONT CAP HARNESS DOME LIGHTS HARNESS

ELECTRICAL PANEL

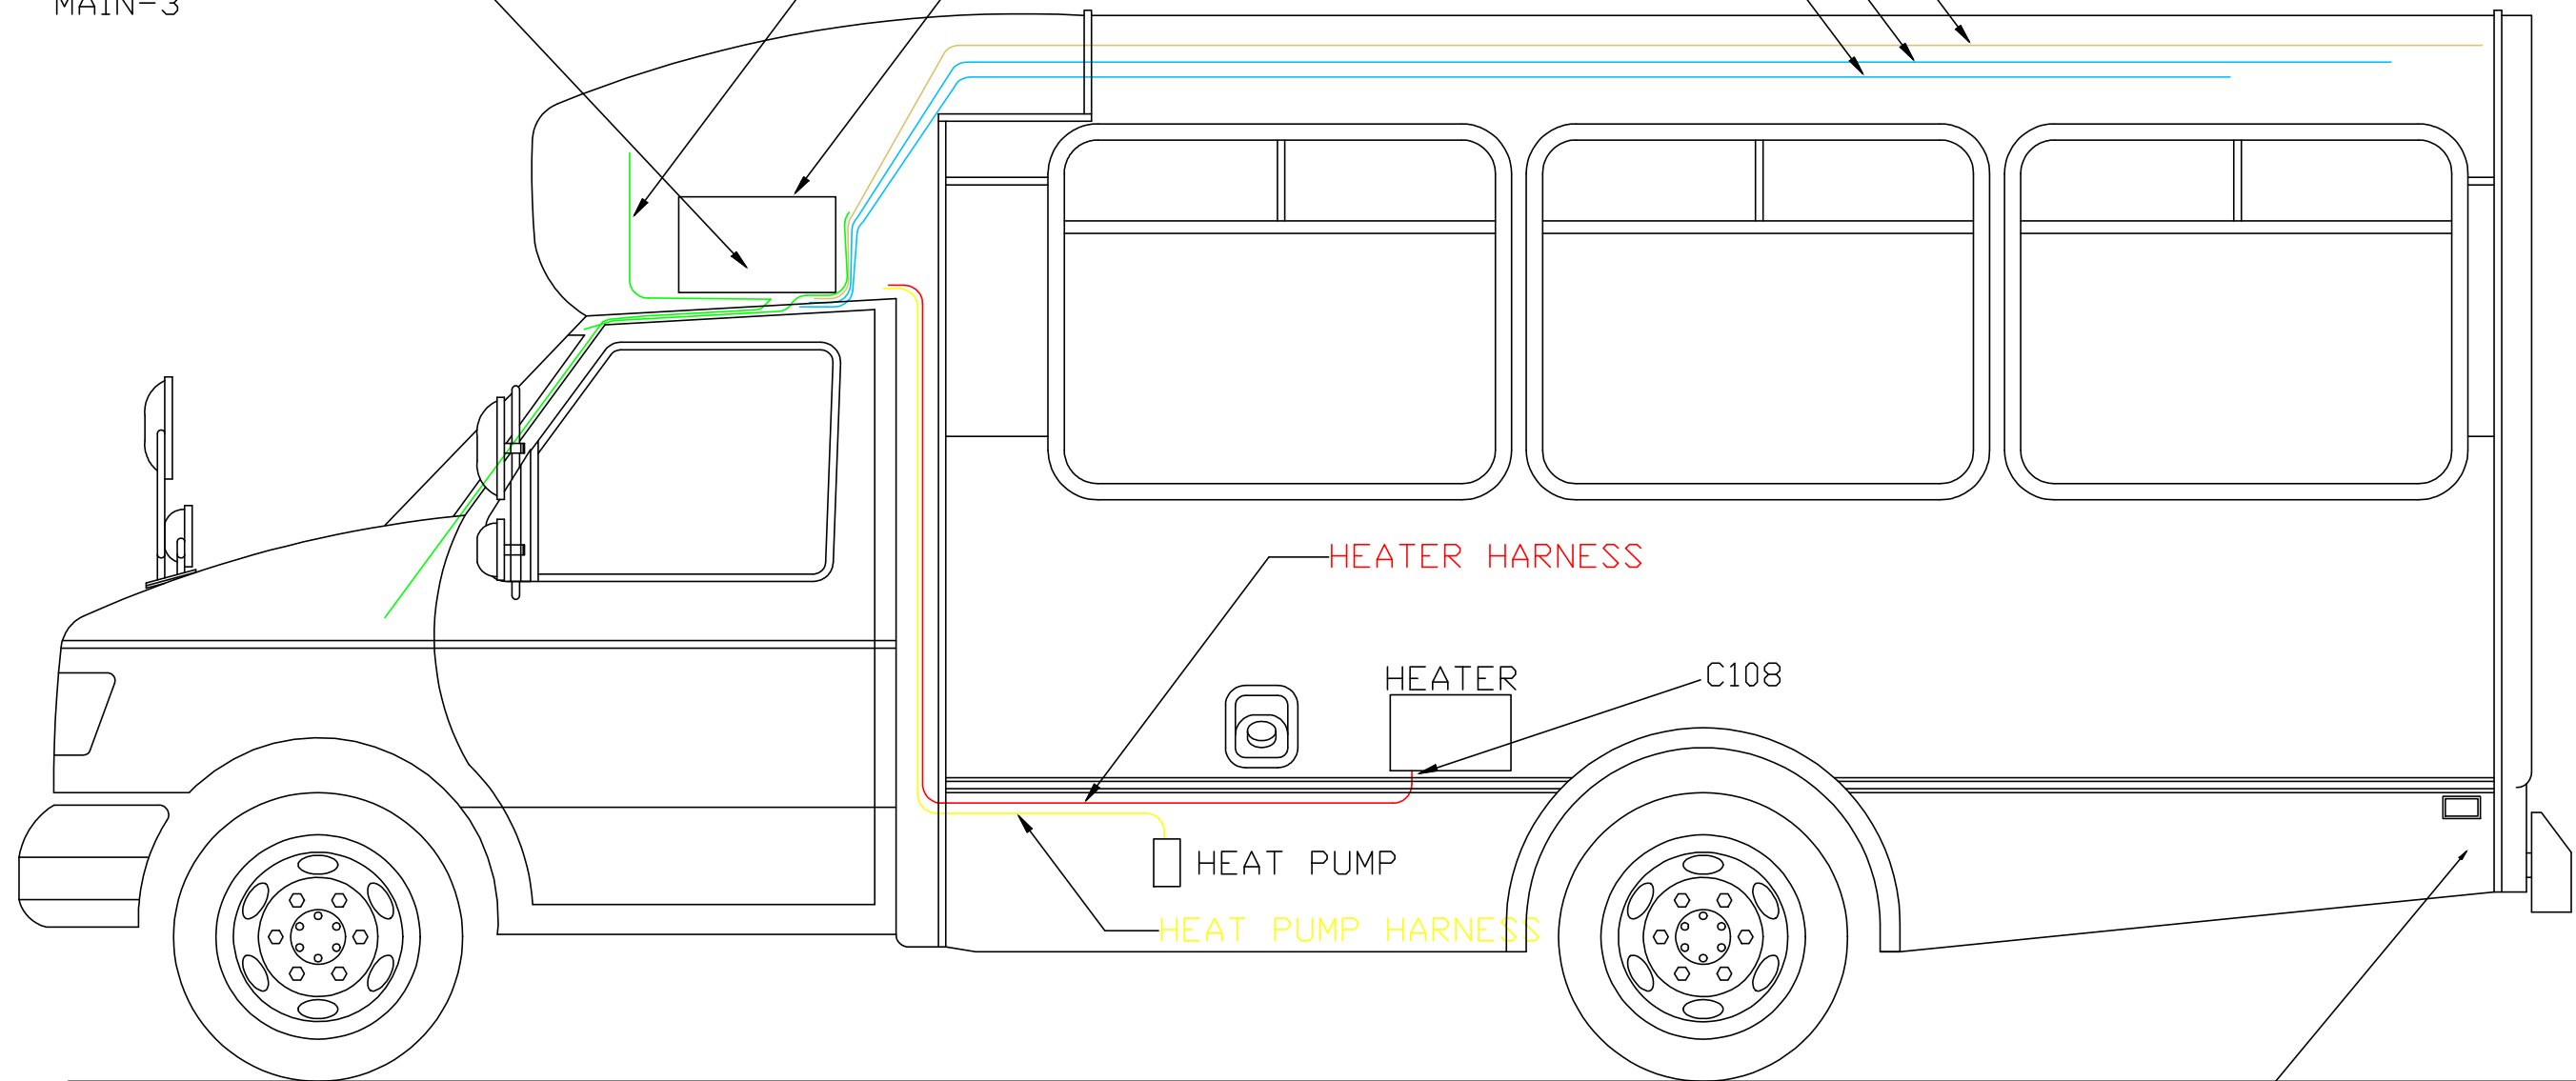


CHASSIS TIE
 IN HARNESS C215

												APPROVED BY: DD	ERN#:	TITLE: ASBUILT FORD ANALOG	REFERENCE DWG: FORD
R DATE	ERN	DESCRIPTION OF CHANGES	BY	R DATE	ERN	DESCRIPTION OF CHANGES	BY	DO NOT SCALE SCALE: N/A	DRAWN BY: CUSTOMER LB PDOT	MODEL: FORD	DWG. NO. SHEET 1 OF 1	RELEASE DATE: 5/11/11	CBI UNIT NUMBERS:		

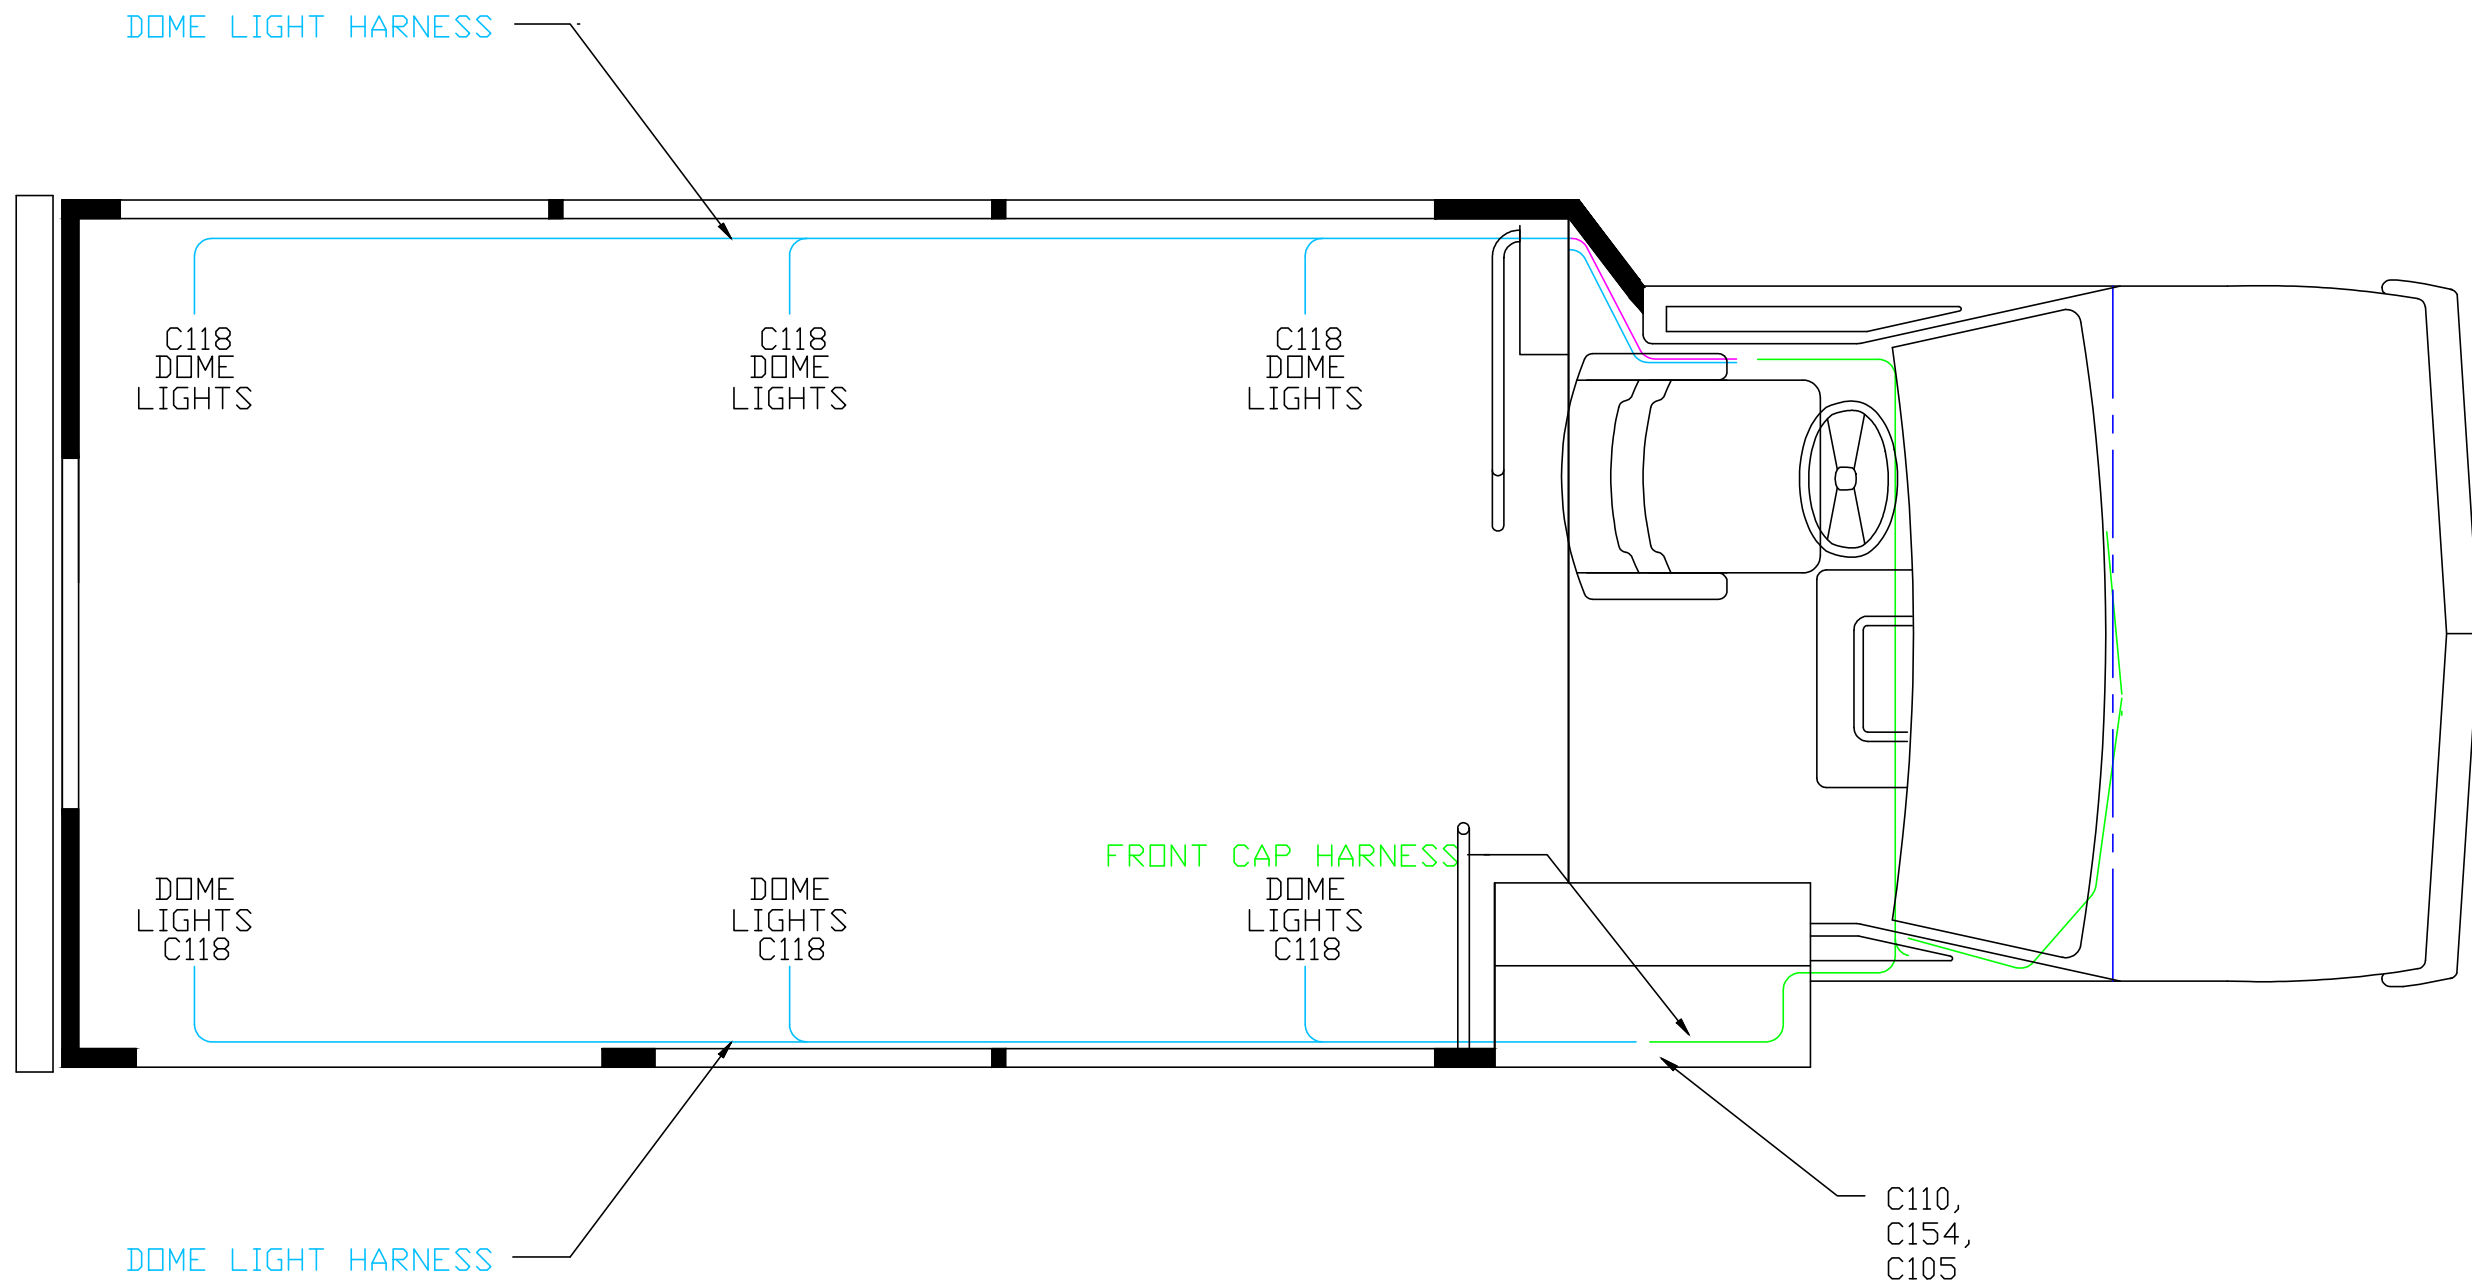


												APPROVED BY: DD	ERN#:	TITLE: ASBUILT FORD ANALOG	REFERENCE DWG: FORD
R DATE ERN	DESCRIPTION OF CHANGES	BY R DATE ERN	DESCRIPTION OF CHANGES	BY	DO NOT SCALE SCALE: N/A	DRAWN BY: CUSTOMER: LB PDOT	MODEL: FORD	DWG. NO. SHEET 1 OF 1	RELEASE DATE: 5/11/11	CBI UNIT NUMBERS:					

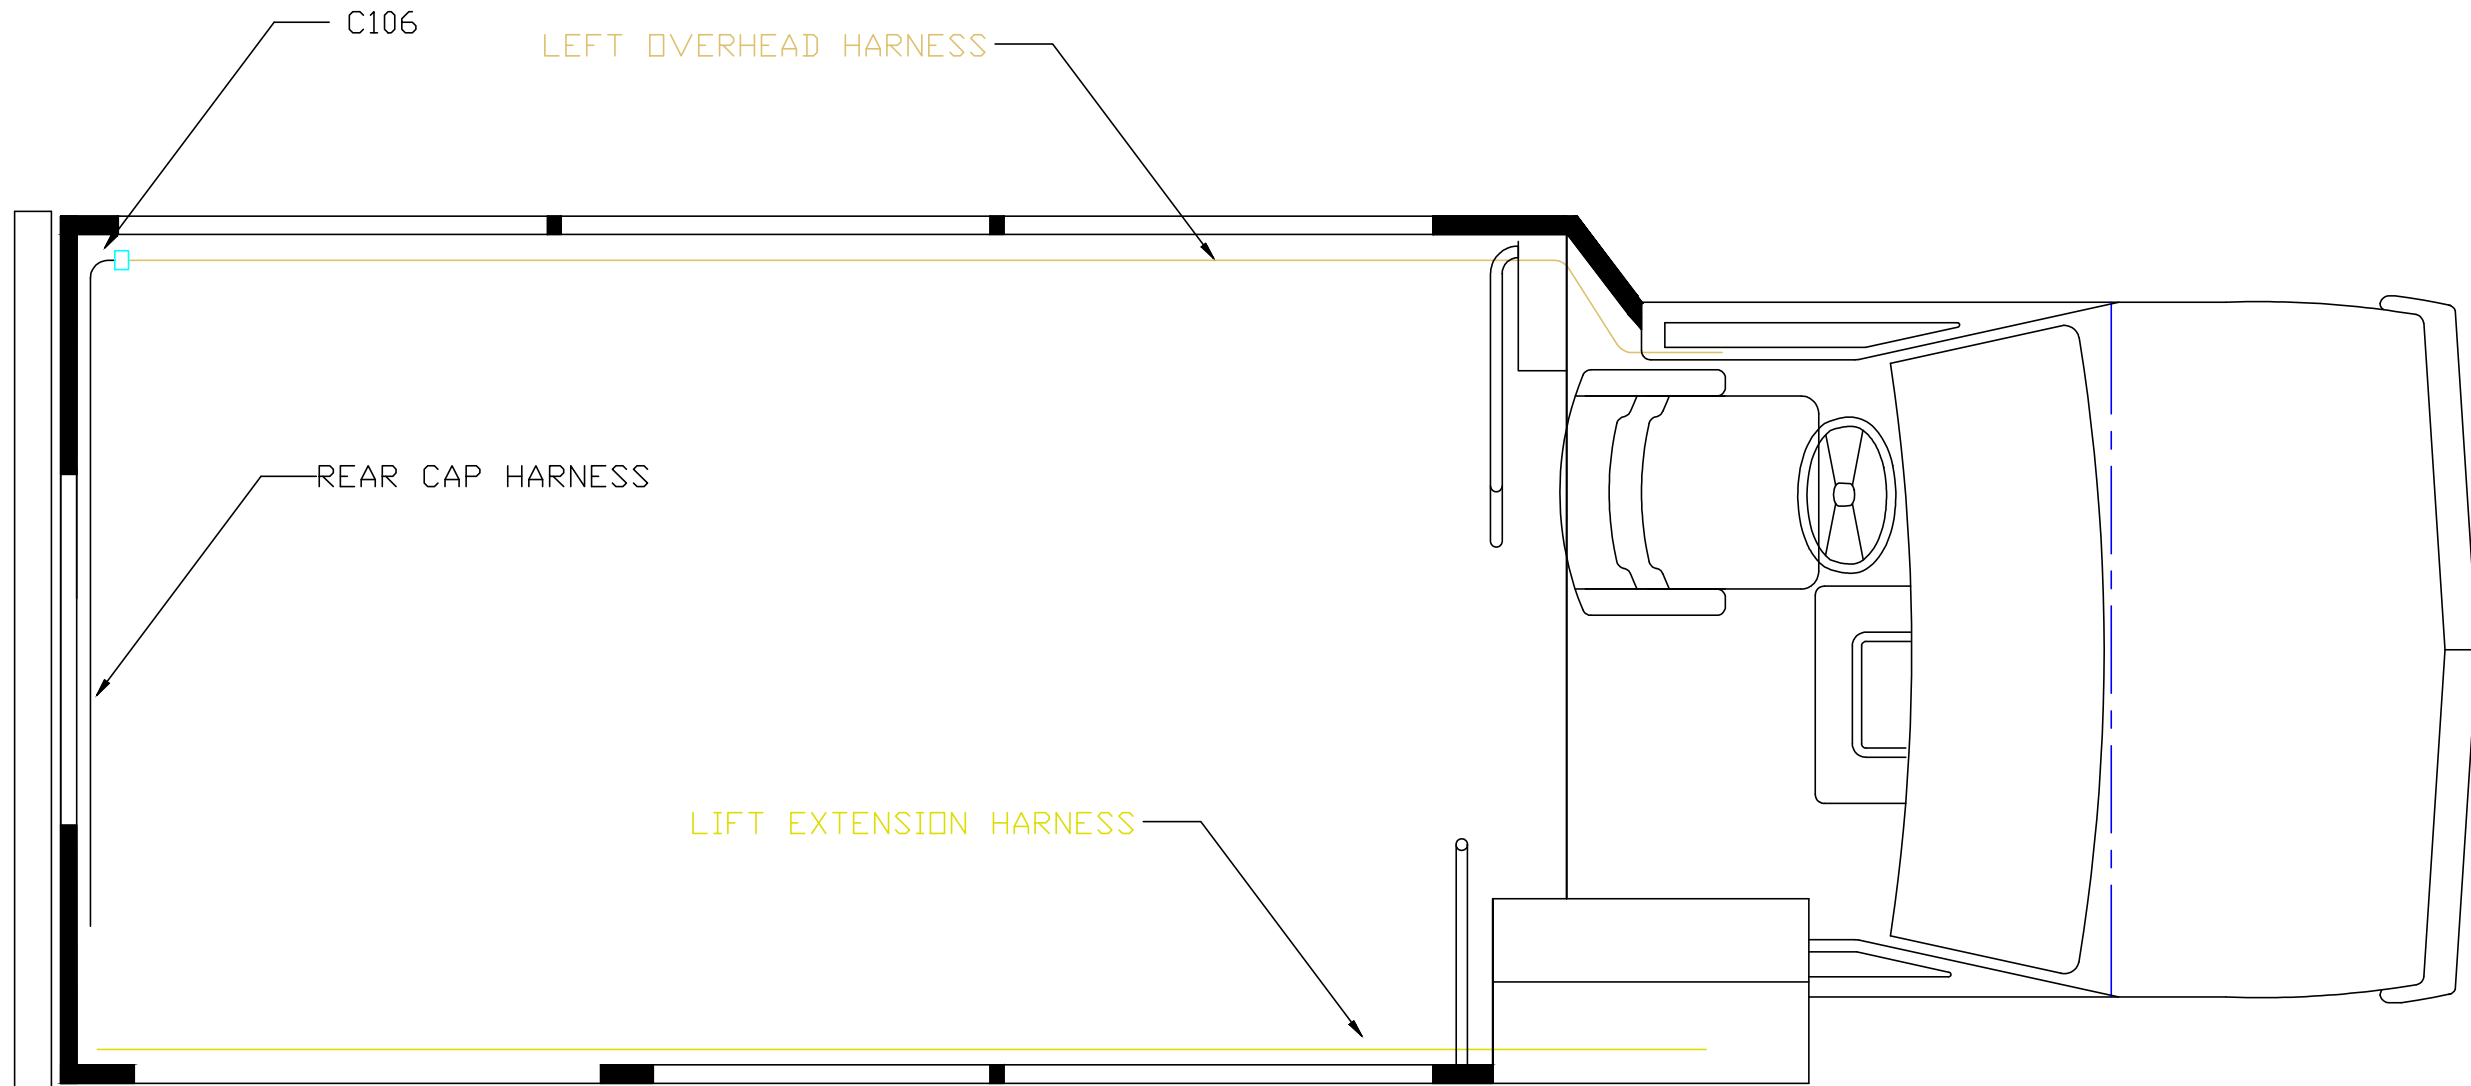

REV	DATE	BY	DESCRIPTION OF CHANGES



APPROVED BY: DD	ERN#:	TITLE: ASBUILT FORD ANALOG	REFERENCE DWG: FORD
P/M: M	DO NOT SCALE SCALE: N/A	DRAWN BY: CUSTOMER: LB PDOT	MODEL: FORD
DWG. NO. SHEET 1 OF 1		RELEASE DATE: 5/11/11	CBI UNIT NUMBERS:

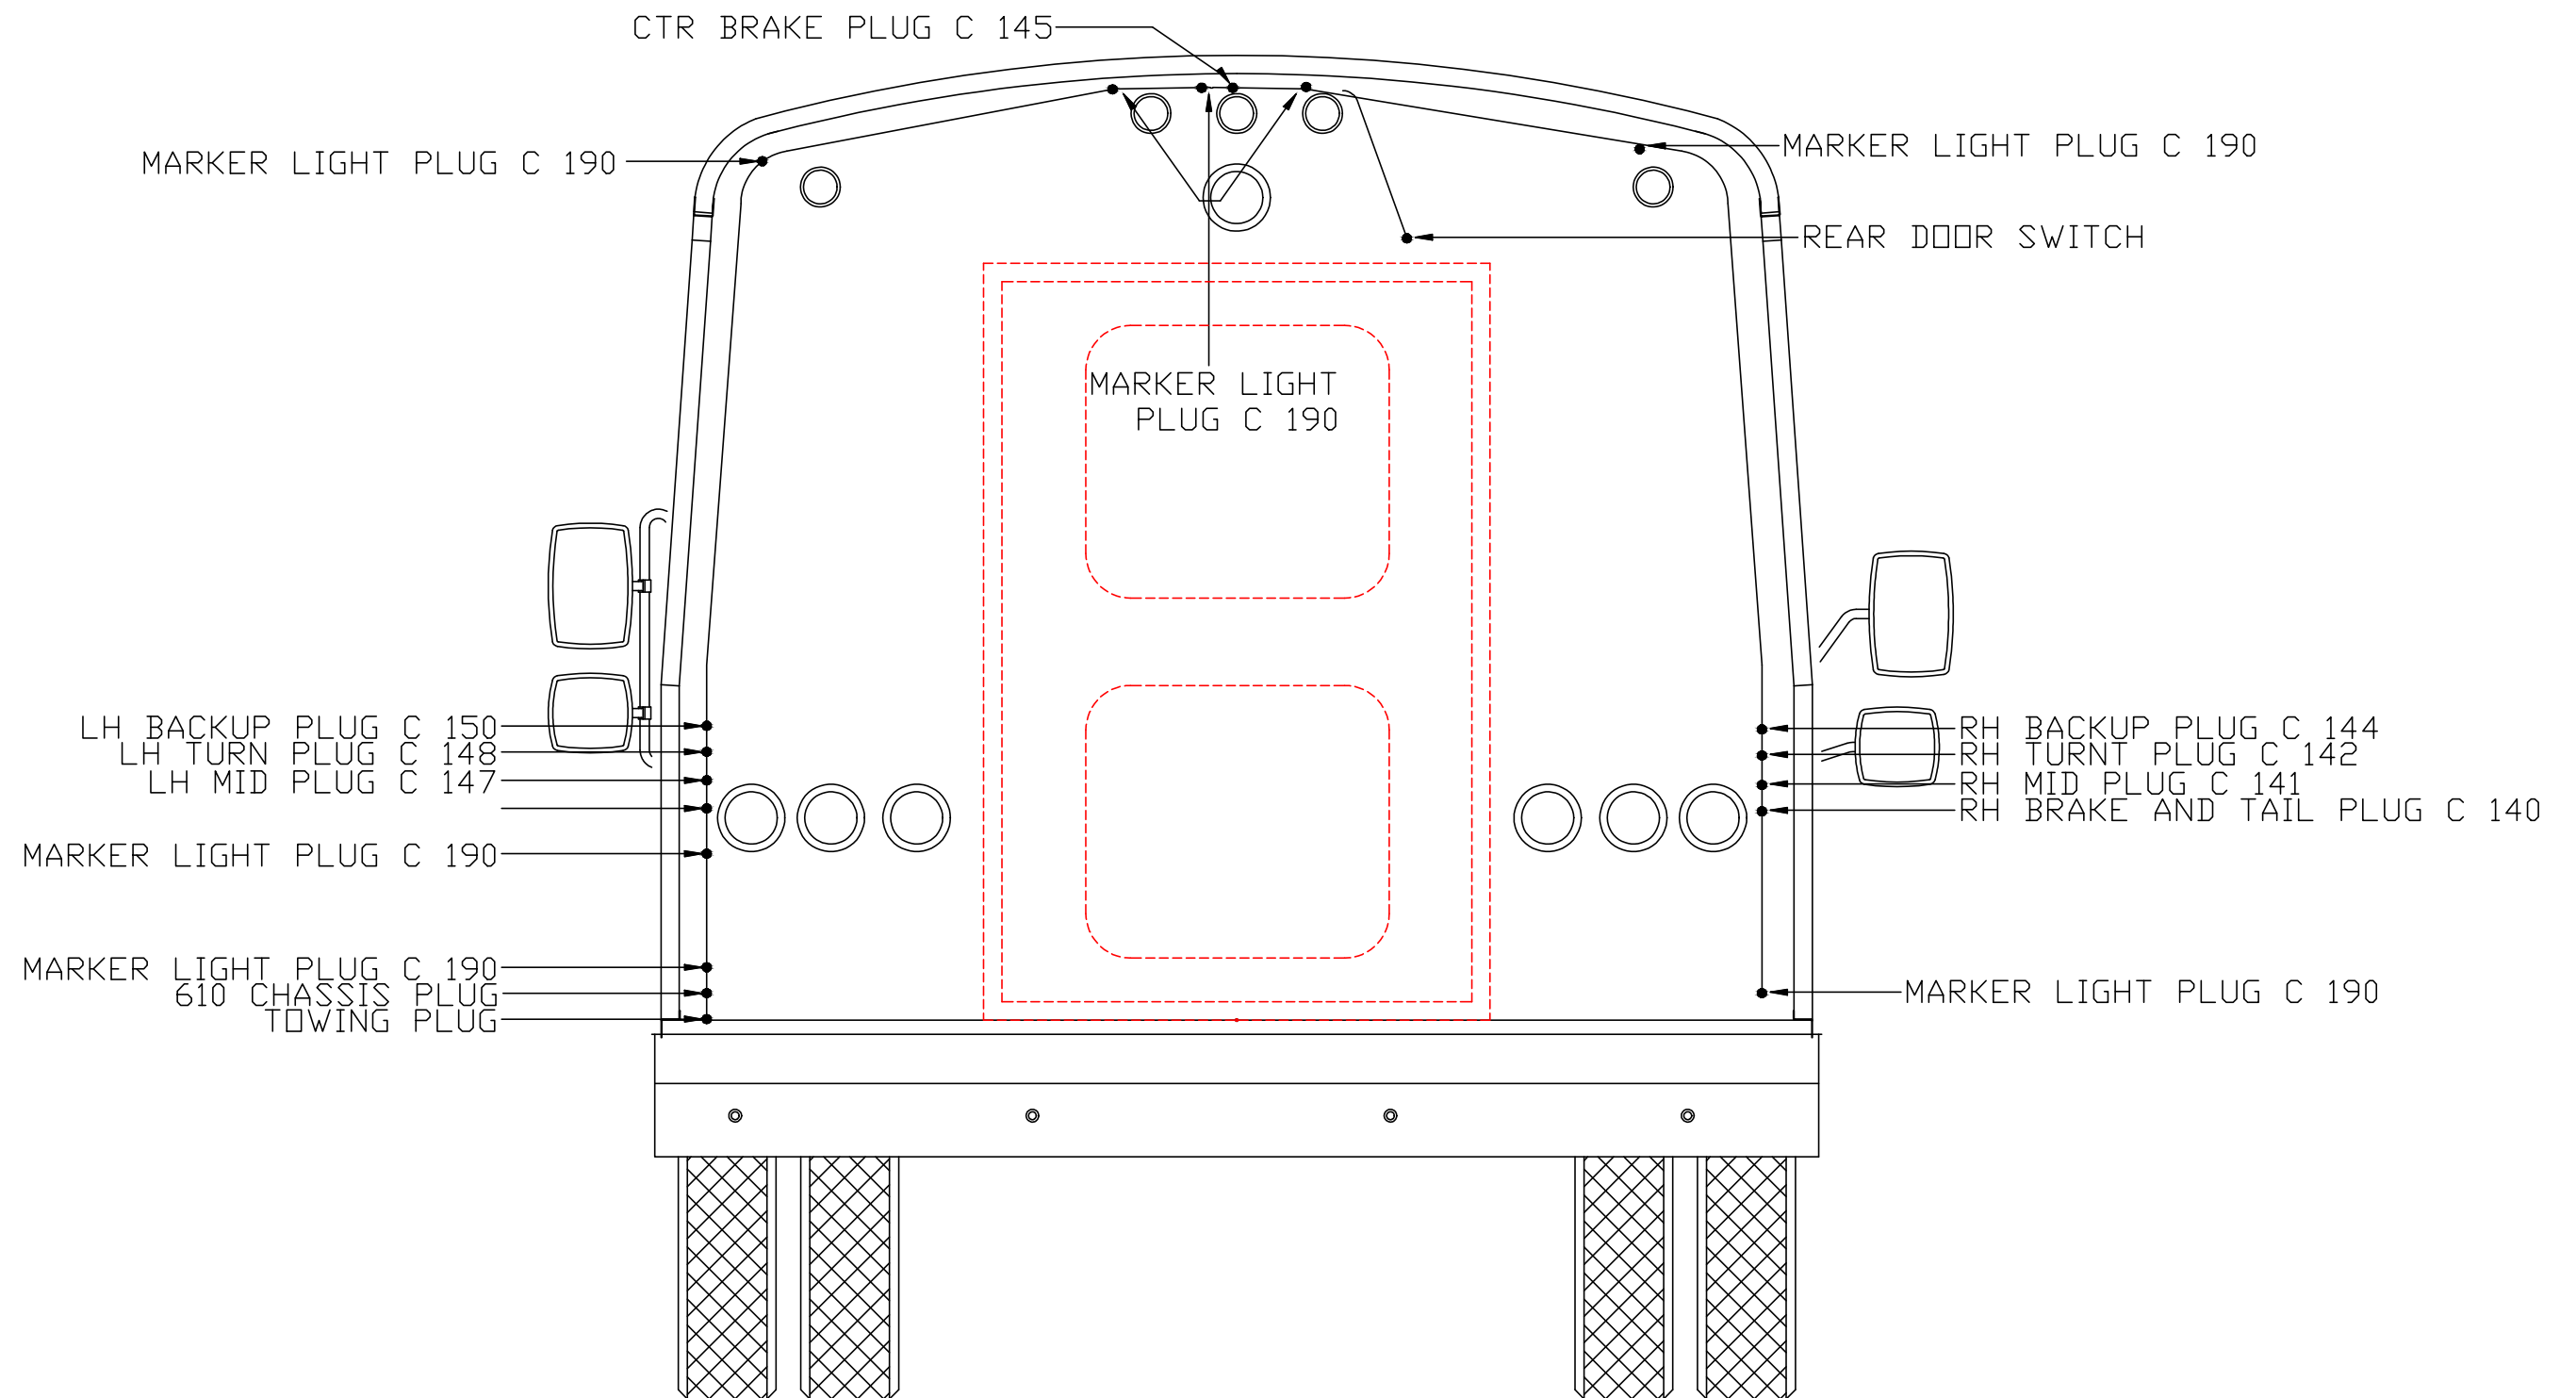

										APPROVED BY: DD		ERN#:		TITLE: ASBUILT FORD ANALOG		REFERENCE DWG: FORD							
										E/ME: M		DO NOT SCALE: N/A		DRAWN BY: LB PDDT		MODEL: FORD		DWG. NO. SHEET 1 OF 1		RELEASE DATE: 5/11/11		CBI UNIT NUMBERS:	
DATE	ERN	DESCRIPTION OF CHANGES	BY	DATE	ERN	DESCRIPTION OF CHANGES	BY																