





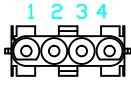

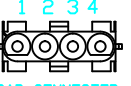






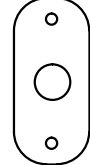











A-PADS MODULE


POWER STUD
A/C POWER










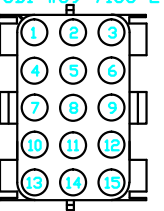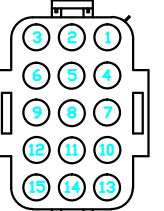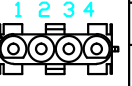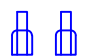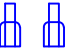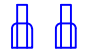


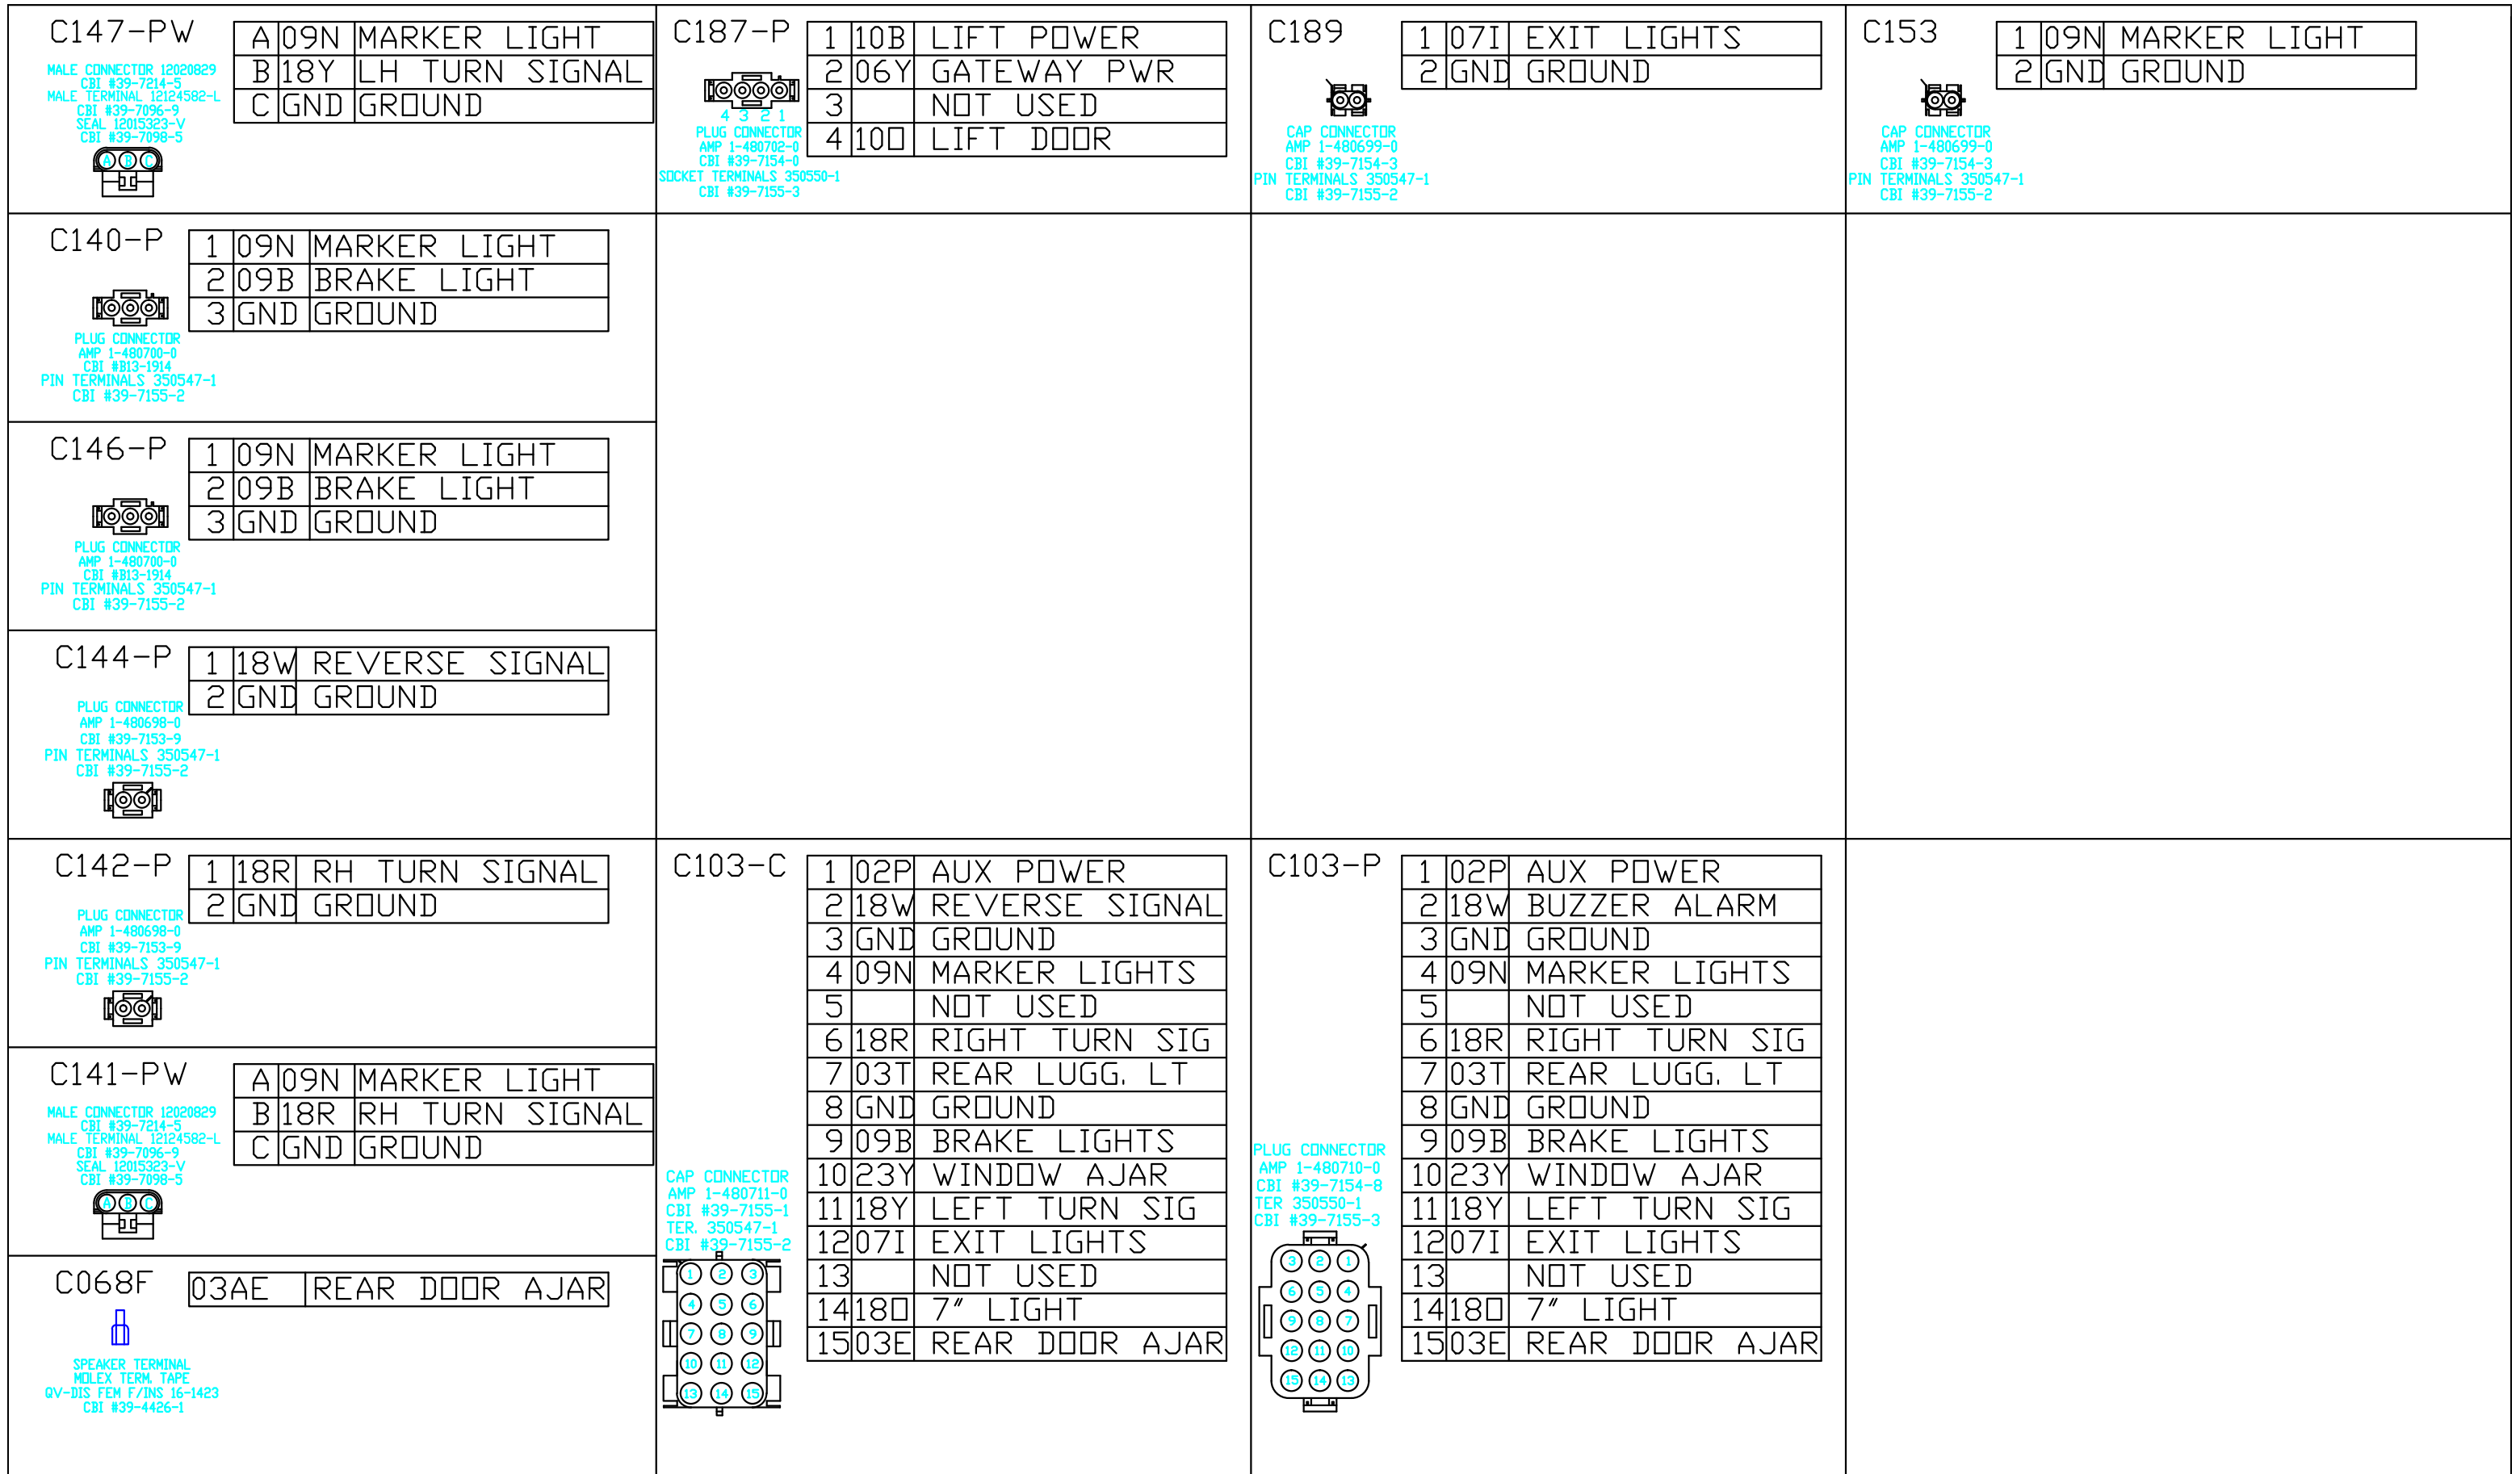

FUSES/BREAKERS		FUSES/BREAKERS		FUSES/BREAKERS	
1	BUZZER	10	CLEARANCE LTS	19	RADIO BATTERY
2	IGN SIGNAL/STEP LTS	11	SPARE IGNITION	20	SPARE IGNITION
3	RADIO IGNITION	12	NOT USED	21	NOT USED
4	NOT USED	13	NOT USED	22	SPARE BATT
5	RIGHT READING	14	DASH IGN	23	SPARE BATT
6	A/C IGNITION	15	LUGGAGE/EXIT LT	24	SPARE BATT
7	HEAT 2 POWER	16	LEFT READING		
8	CENTER LIGHTS	17	ELECTRIC DOOR		
9	HEAT 1 POWER	18	DOOR SWITCH/LFT INT		

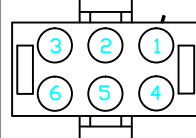
GMT610 ANALOG
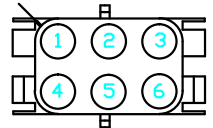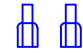
<p>C148-P</p> <table border="1"> <tr><td>1</td><td>18Y</td><td>LH TURN SIGNAL</td></tr> <tr><td>2</td><td>GND</td><td>GROUND</td></tr> </table> <p>PLUG CONNECTOR AMP 1-480698-0 CBI #39-7153-9 PIN TERMINALS 350547-1 CBI #39-7155-2</p> 	1	18Y	LH TURN SIGNAL	2	GND	GROUND	<p>C110-C</p> <table border="1"> <tr><td>1</td><td>04I</td><td>LIFT STOWED</td></tr> <tr><td>2</td><td>GND</td><td>GROUND</td></tr> </table> <p>CAP CONNECTOR AMP 1-480699-0 CBI #39-7154-3 PIN TERMINALS 350547-1 CBI #39-7155-2</p> 	1	04I	LIFT STOWED	2	GND	GROUND	<p>C118-C</p> <table border="1"> <tr><td>1</td><td>08K</td><td>DOME LIGHTS</td></tr> <tr><td>2</td><td>GND</td><td>GROUND</td></tr> </table> <p>CAP CONNECTOR AMP 1-480699-0 CBI #39-7154-3 PIN TERMINALS 350547-1 CBI #39-7155-2</p> 	1	08K	DOME LIGHTS	2	GND	GROUND	<p>C116-C</p> <table border="1"> <tr><td>1</td><td>09W</td><td>DOOR CLOSE</td></tr> <tr><td>2</td><td>GND</td><td>GROUND</td></tr> <tr><td>3</td><td>09Y</td><td>DOOR OPEN</td></tr> <tr><td>4</td><td>10R</td><td>DOOR BATT PWR</td></tr> </table> <p>CAP CONNECTOR AMP 1-480703-0 CBI #39-7154-4 PIN TERMINALS 350547-1 CBI #39-7155-2</p> 	1	09W	DOOR CLOSE	2	GND	GROUND	3	09Y	DOOR OPEN	4	10R	DOOR BATT PWR																																																																								
1	18Y	LH TURN SIGNAL																																																																																																							
2	GND	GROUND																																																																																																							
1	04I	LIFT STOWED																																																																																																							
2	GND	GROUND																																																																																																							
1	08K	DOME LIGHTS																																																																																																							
2	GND	GROUND																																																																																																							
1	09W	DOOR CLOSE																																																																																																							
2	GND	GROUND																																																																																																							
3	09Y	DOOR OPEN																																																																																																							
4	10R	DOOR BATT PWR																																																																																																							
<p>C150-P</p> <table border="1"> <tr><td>1</td><td>18W</td><td>LH REVERSE LT</td></tr> <tr><td>2</td><td>GND</td><td>GROUND</td></tr> </table> <p>PLUG CONNECTOR AMP 1-480698-0 CBI #39-7153-9 PIN TERMINALS 350547-1 CBI #39-7155-2</p> 	1	18W	LH REVERSE LT	2	GND	GROUND	<p>C108-C</p> <table border="1"> <tr><td>1</td><td>04P</td><td>HEATER #2 HIGH</td></tr> <tr><td>2</td><td></td><td></td></tr> <tr><td>3</td><td>04Q</td><td>HEATER #2 LOW</td></tr> <tr><td>4</td><td>GND</td><td>HEATER GROUND</td></tr> </table> <p>CAP CONNECTOR AMP 1-480703-0 CBI #39-7154-4 PIN TERMINALS 350547-1 CBI #39-7155-2</p> 	1	04P	HEATER #2 HIGH	2			3	04Q	HEATER #2 LOW	4	GND	HEATER GROUND	<p>C154-C</p> <table border="1"> <tr><td>1</td><td>08K</td><td>DOME LIGHTS</td></tr> <tr><td>2</td><td>GND</td><td>GROUND</td></tr> </table> <p>CAP CONNECTOR AMP 1-480699-0 CBI #39-7154-3 PIN TERMINALS 350547-1 CBI #39-7155-2</p> 	1	08K	DOME LIGHTS	2	GND	GROUND	<p>C165-C</p> <table border="1"> <tr><td>1</td><td>GND</td><td>GROUND</td></tr> <tr><td>2</td><td>09Q</td><td>ENTRY LIGHTS</td></tr> </table> <p>CAP CONNECTOR AMP 1-480699-0 CBI #39-7154-3 PIN TERMINALS 350547-1 CBI #39-7155-2</p> 	1	GND	GROUND	2	09Q	ENTRY LIGHTS																																																																								
1	18W	LH REVERSE LT																																																																																																							
2	GND	GROUND																																																																																																							
1	04P	HEATER #2 HIGH																																																																																																							
2																																																																																																									
3	04Q	HEATER #2 LOW																																																																																																							
4	GND	HEATER GROUND																																																																																																							
1	08K	DOME LIGHTS																																																																																																							
2	GND	GROUND																																																																																																							
1	GND	GROUND																																																																																																							
2	09Q	ENTRY LIGHTS																																																																																																							
<p>C190E/F-C</p> <table border="1"> <tr><td>A</td><td>09N</td><td>MARKER LIGHTS</td></tr> <tr><td>B</td><td>GND</td><td>GROUND</td></tr> </table> <p>FEMALE CONNECTOR 12010973 CBI #39-7185-5 MALE TERMINAL 12124582-L CBI #39-7096-9 SEAL 12015323-V CBI #39-7098-5</p> 	A	09N	MARKER LIGHTS	B	GND	GROUND	<p>C108A-P</p> <table border="1"> <tr><td>1</td><td>04P</td><td>HEATER #2 HIGH</td></tr> <tr><td>2</td><td></td><td></td></tr> <tr><td>3</td><td>04Q</td><td>HEATER #2 LOW</td></tr> <tr><td>4</td><td>GND</td><td>HEATER GROUND</td></tr> </table> <p>PLUG CONNECTOR AMP 1-480702-0 CBI #39-7154-0 SOCKET TERMINALS 350550-1 CBI #39-7155-3</p> 	1	04P	HEATER #2 HIGH	2			3	04Q	HEATER #2 LOW	4	GND	HEATER GROUND	<p>C154-P</p> <table border="1"> <tr><td>1</td><td>08K</td><td>DOME LIGHTS</td></tr> <tr><td>2</td><td>GND</td><td>GROUND</td></tr> </table> <p>PLUG CONNECTOR AMP 1-480698-0 CBI #39-7153-9 SOCKET TERMINALS 350550-1 CBI #39-7155-3</p> 	1	08K	DOME LIGHTS	2	GND	GROUND	<p>C165-P</p> <table border="1"> <tr><td>1</td><td>GND</td><td>GROUND</td></tr> <tr><td>2</td><td>09Q</td><td>ENTRY LIGHTS</td></tr> </table> <p>PLUG CONNECTOR AMP 1-480698-0 CBI #39-7153-9 SOCKET TERMINALS 350550-1 CBI #39-7155-3</p> 	1	GND	GROUND	2	09Q	ENTRY LIGHTS																																																																								
A	09N	MARKER LIGHTS																																																																																																							
B	GND	GROUND																																																																																																							
1	04P	HEATER #2 HIGH																																																																																																							
2																																																																																																									
3	04Q	HEATER #2 LOW																																																																																																							
4	GND	HEATER GROUND																																																																																																							
1	08K	DOME LIGHTS																																																																																																							
2	GND	GROUND																																																																																																							
1	GND	GROUND																																																																																																							
2	09Q	ENTRY LIGHTS																																																																																																							
<p>C190-C</p> <table border="1"> <tr><td>1</td><td>09N</td><td>MARKER LIGHTS</td></tr> <tr><td>2</td><td>GND</td><td>GROUND</td></tr> </table> <p>CAP CONNECTOR AMP 1-480699-0 CBI #39-7154-3 PIN TERMINALS 350547-1 CBI #39-7155-2</p> 	1	09N	MARKER LIGHTS	2	GND	GROUND	<p>C108-P</p> <table border="1"> <tr><td>1</td><td>07P</td><td>HEATER #1 HIGH</td></tr> <tr><td>2</td><td></td><td></td></tr> <tr><td>3</td><td>07Q</td><td>HEATER #1 LOW</td></tr> <tr><td>4</td><td>GND</td><td>HEATER GROUND</td></tr> </table> <p>PLUG CONNECTOR AMP 1-480702-0 CBI #39-7154-0 SOCKET TERMINALS 350550-1 CBI #39-7155-3</p> 	1	07P	HEATER #1 HIGH	2			3	07Q	HEATER #1 LOW	4	GND	HEATER GROUND	<p>C157-C</p> <table border="1"> <tr><td>1</td><td>07I</td><td>EXIT LIGHTS</td></tr> <tr><td>2</td><td>GND</td><td>GROUND</td></tr> </table> <p>CAP CONNECTOR AMP 1-480699-0 CBI #39-7154-3 PIN TERMINALS 350547-1 CBI #39-7155-2</p> 	1	07I	EXIT LIGHTS	2	GND	GROUND	<p>C163B-P</p> <table border="1"> <tr><td>1</td><td>08AI</td><td>LIFT LIGHTS</td></tr> <tr><td>2</td><td>10B</td><td>LIFT POWER</td></tr> <tr><td>3</td><td>GND</td><td>GROUND</td></tr> <tr><td>4</td><td>10D</td><td>LIFT DOOR AJAR</td></tr> </table> <p>PLUG CONNECTOR AMP 1-480702-0 CBI #39-7154-0 PIN TERMINALS 350547-1 CBI #39-7155-2</p> 	1	08AI	LIFT LIGHTS	2	10B	LIFT POWER	3	GND	GROUND	4	10D	LIFT DOOR AJAR																																																																		
1	09N	MARKER LIGHTS																																																																																																							
2	GND	GROUND																																																																																																							
1	07P	HEATER #1 HIGH																																																																																																							
2																																																																																																									
3	07Q	HEATER #1 LOW																																																																																																							
4	GND	HEATER GROUND																																																																																																							
1	07I	EXIT LIGHTS																																																																																																							
2	GND	GROUND																																																																																																							
1	08AI	LIFT LIGHTS																																																																																																							
2	10B	LIFT POWER																																																																																																							
3	GND	GROUND																																																																																																							
4	10D	LIFT DOOR AJAR																																																																																																							
<p>C145-P</p> <table border="1"> <tr><td>1</td><td>09B</td><td>CEN.BRAKE LIGHT</td></tr> <tr><td>2</td><td>GND</td><td>GROUND</td></tr> </table> <p>PLUG CONNECTOR AMP 1-480698-0 CBI #39-7153-9 PIN TERMINALS 350547-1 CBI #39-7155-2</p> 	1	09B	CEN.BRAKE LIGHT	2	GND	GROUND	<p>C109-C</p> <table border="1"> <tr><td>1</td><td>09N</td><td>MARKER LIGHT</td></tr> <tr><td>2</td><td>GND</td><td>GROUND</td></tr> </table> <p>CAP CONNECTOR AMP 1-480699-0 CBI #39-7154-3 PIN TERMINALS 350547-1 CBI #39-7155-2</p> 	1	09N	MARKER LIGHT	2	GND	GROUND	<p>C106-C</p> <table border="1"> <tr><td>1</td><td>02P</td><td>AUX POWER</td></tr> <tr><td>2</td><td>18W</td><td>REVERSE SIGNAL</td></tr> <tr><td>3</td><td>GND</td><td>GROUND</td></tr> <tr><td>4</td><td>09N</td><td>MARKER LIGHTS</td></tr> <tr><td>5</td><td></td><td>NOT USED</td></tr> <tr><td>6</td><td>18R</td><td>RIGHT TURN SIG</td></tr> <tr><td>7</td><td>03T</td><td>REAR LUGG. LT</td></tr> <tr><td>8</td><td>GND</td><td>GROUND</td></tr> <tr><td>9</td><td>09B</td><td>BRAKE LIGHTS</td></tr> <tr><td>10</td><td>23Y</td><td>WINDOW AJAR</td></tr> <tr><td>11</td><td>18Y</td><td>LEFT TURN SIG</td></tr> <tr><td>12</td><td>07I</td><td>EXIT LIGHTS</td></tr> <tr><td>13</td><td></td><td>NOT USED</td></tr> <tr><td>14</td><td>18Q</td><td>7" LIGHT</td></tr> <tr><td>15</td><td>03E</td><td>REAR DOOR AJAR</td></tr> </table> <p>CAP CONNECTOR AMP 1-480711-0 CBI #39-7155-1 TER. 350547-1 CBI #39-7155-2</p> 	1	02P	AUX POWER	2	18W	REVERSE SIGNAL	3	GND	GROUND	4	09N	MARKER LIGHTS	5		NOT USED	6	18R	RIGHT TURN SIG	7	03T	REAR LUGG. LT	8	GND	GROUND	9	09B	BRAKE LIGHTS	10	23Y	WINDOW AJAR	11	18Y	LEFT TURN SIG	12	07I	EXIT LIGHTS	13		NOT USED	14	18Q	7" LIGHT	15	03E	REAR DOOR AJAR	<p>C106-P</p> <table border="1"> <tr><td>1</td><td>02P</td><td>AUX POWER</td></tr> <tr><td>2</td><td>18W</td><td>BUZZER ALARM</td></tr> <tr><td>3</td><td>GND</td><td>GROUND</td></tr> <tr><td>4</td><td>09N</td><td>MARKER LIGHTS</td></tr> <tr><td>5</td><td></td><td>NOT USED</td></tr> <tr><td>6</td><td>18R</td><td>RIGHT TURN SIG</td></tr> <tr><td>7</td><td>03T</td><td>REAR LUGG. LT</td></tr> <tr><td>8</td><td>GND</td><td>GROUND</td></tr> <tr><td>9</td><td>09B</td><td>BRAKE LIGHTS</td></tr> <tr><td>10</td><td>23Y</td><td>WINDOW AJAR</td></tr> <tr><td>11</td><td>18Y</td><td>LEFT TURN SIG</td></tr> <tr><td>12</td><td>07I</td><td>EXIT LIGHTS</td></tr> <tr><td>13</td><td></td><td>NOT USED</td></tr> <tr><td>14</td><td>18Q</td><td>7" LIGHT</td></tr> <tr><td>15</td><td>03E</td><td>REAR DOOR AJAR</td></tr> </table> <p>PLUG CONNECTOR AMP 1-480710-0 CBI #39-7154-8 TER 350550-1 CBI #39-7155-3</p> 	1	02P	AUX POWER	2	18W	BUZZER ALARM	3	GND	GROUND	4	09N	MARKER LIGHTS	5		NOT USED	6	18R	RIGHT TURN SIG	7	03T	REAR LUGG. LT	8	GND	GROUND	9	09B	BRAKE LIGHTS	10	23Y	WINDOW AJAR	11	18Y	LEFT TURN SIG	12	07I	EXIT LIGHTS	13		NOT USED	14	18Q	7" LIGHT	15	03E	REAR DOOR AJAR
1	09B	CEN.BRAKE LIGHT																																																																																																							
2	GND	GROUND																																																																																																							
1	09N	MARKER LIGHT																																																																																																							
2	GND	GROUND																																																																																																							
1	02P	AUX POWER																																																																																																							
2	18W	REVERSE SIGNAL																																																																																																							
3	GND	GROUND																																																																																																							
4	09N	MARKER LIGHTS																																																																																																							
5		NOT USED																																																																																																							
6	18R	RIGHT TURN SIG																																																																																																							
7	03T	REAR LUGG. LT																																																																																																							
8	GND	GROUND																																																																																																							
9	09B	BRAKE LIGHTS																																																																																																							
10	23Y	WINDOW AJAR																																																																																																							
11	18Y	LEFT TURN SIG																																																																																																							
12	07I	EXIT LIGHTS																																																																																																							
13		NOT USED																																																																																																							
14	18Q	7" LIGHT																																																																																																							
15	03E	REAR DOOR AJAR																																																																																																							
1	02P	AUX POWER																																																																																																							
2	18W	BUZZER ALARM																																																																																																							
3	GND	GROUND																																																																																																							
4	09N	MARKER LIGHTS																																																																																																							
5		NOT USED																																																																																																							
6	18R	RIGHT TURN SIG																																																																																																							
7	03T	REAR LUGG. LT																																																																																																							
8	GND	GROUND																																																																																																							
9	09B	BRAKE LIGHTS																																																																																																							
10	23Y	WINDOW AJAR																																																																																																							
11	18Y	LEFT TURN SIG																																																																																																							
12	07I	EXIT LIGHTS																																																																																																							
13		NOT USED																																																																																																							
14	18Q	7" LIGHT																																																																																																							
15	03E	REAR DOOR AJAR																																																																																																							
<p>C163-C</p> <table border="1"> <tr><td>1</td><td>08AI</td><td>LIFT LIGHTS</td></tr> <tr><td>2</td><td>10B</td><td>LIFT POWER</td></tr> <tr><td>3</td><td>GND</td><td>GROUND</td></tr> <tr><td>4</td><td>10D</td><td>LIFT DOOR AJAR</td></tr> </table> <p>CAP CONNECTOR AMP 1-480703-0 CBI #39-7154-4 SOCKET TERMINALS 350550-1 CBI #39-7155-3</p> 	1	08AI	LIFT LIGHTS	2	10B	LIFT POWER	3	GND	GROUND	4	10D	LIFT DOOR AJAR	<p>C124</p> <table border="1"> <tr><td>28W</td><td>LEFT FRONT SPK</td></tr> <tr><td>28W/K</td><td>LEFT FRONT SPK</td></tr> </table> <p>SPEAKER TERMINAL MOLEX TERM. TAPE QV-DIS FEM F/INS 16-1423 CBI #39-4426-1</p> 	28W	LEFT FRONT SPK	28W/K	LEFT FRONT SPK	<p>C129</p> <table border="1"> <tr><td>28E</td><td>RT FRONT SPK</td></tr> <tr><td>28E/K</td><td>RT FRONT SPK</td></tr> </table> <p>SPEAKER TERMINAL MOLEX TERM. TAPE QV-DIS FEM F/INS 16-1423 CBI #39-4426-1</p> 	28E	RT FRONT SPK	28E/K	RT FRONT SPK	<p>L907</p> <table border="1"> <tr><td>08AI</td><td>LIFT LIGHTS</td></tr> <tr><td>GND</td><td>GROUND</td></tr> </table> <p>SPEAKER TERMINAL MOLEX TERM. TAPE QV-DIS FEM F/INS 16-1423 CBI #39-4426-1</p> 	08AI	LIFT LIGHTS	GND	GROUND																																																																														
1	08AI	LIFT LIGHTS																																																																																																							
2	10B	LIFT POWER																																																																																																							
3	GND	GROUND																																																																																																							
4	10D	LIFT DOOR AJAR																																																																																																							
28W	LEFT FRONT SPK																																																																																																								
28W/K	LEFT FRONT SPK																																																																																																								
28E	RT FRONT SPK																																																																																																								
28E/K	RT FRONT SPK																																																																																																								
08AI	LIFT LIGHTS																																																																																																								
GND	GROUND																																																																																																								

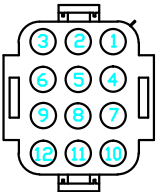


<p>A-CW/D-CW</p> <p>FEMALE CONNECTOR 12010973 CBI #39-7185-5 MALE TERMINAL 12124582-L CBI #39-7096-9 SEAL 12015323-V CBI #39-7098-5</p>  <table border="1"> <tr><td>B</td><td>GND</td><td>GROUND</td></tr> <tr><td>A</td><td>09</td><td>ENTRY LIGHTS</td></tr> </table>	B	GND	GROUND	A	09	ENTRY LIGHTS	<p>C193-P 1 20P IGNITION TRG</p> <p>BLUNT CUT WIRE</p>																																												
B	GND	GROUND																																																	
A	09	ENTRY LIGHTS																																																	
<p>C113</p>  <p>4 3 2 1 PLUG CONNECTOR AMP 1-480702-0 CBI #39-7154-0 SOCKET TERMINALS 350550-1 CBI #39-7155-3</p> <table border="1"> <tr><td>1</td><td>GND</td><td>GROUND</td></tr> <tr><td>2</td><td>09W</td><td>DOOR CLOSE</td></tr> <tr><td>3</td><td>09Y</td><td>DOOR OPEN</td></tr> <tr><td>4</td><td>10R</td><td>DOOR POWER</td></tr> </table>	1	GND	GROUND	2	09W	DOOR CLOSE	3	09Y	DOOR OPEN	4	10R	DOOR POWER	<p>C161</p> <table border="1"> <tr><td>1</td><td></td><td>NOT USED</td></tr> <tr><td>2</td><td>18W</td><td>REVERSE LIGHTS</td></tr> <tr><td>3</td><td>18Y</td><td>LEFT TURN</td></tr> <tr><td>4</td><td>09N</td><td>MARKER LIGHTS</td></tr> <tr><td>5</td><td>18R</td><td>RIGHT TURN</td></tr> <tr><td>6</td><td>09B</td><td>BRAKE LIGHTS</td></tr> </table>	1		NOT USED	2	18W	REVERSE LIGHTS	3	18Y	LEFT TURN	4	09N	MARKER LIGHTS	5	18R	RIGHT TURN	6	09B	BRAKE LIGHTS	<p>C215</p> <table border="1"> <tr><td>1</td><td></td><td>NOT USED</td></tr> <tr><td>2</td><td>18W</td><td>REVERSE LIGHTS</td></tr> <tr><td>3</td><td>18Y</td><td>LEFT TURN</td></tr> <tr><td>4</td><td>09N</td><td>MARKER LIGHTS</td></tr> <tr><td>5</td><td>18R</td><td>RIGHT TURN</td></tr> <tr><td>6</td><td>09B</td><td>BRAKE LIGHTS</td></tr> </table> <p>PLUG CONNECTOR AMP 1-480704-0 CBI #39-7154-1 SOCKET TERMINALS 350550-1 CBI #39-7155-3</p> 	1		NOT USED	2	18W	REVERSE LIGHTS	3	18Y	LEFT TURN	4	09N	MARKER LIGHTS	5	18R	RIGHT TURN	6	09B	BRAKE LIGHTS	<p>C216-18-P 1 08K DOME LIGHTS 2 GND GROUND</p> <p>PLUG CONNECTOR AMP 1-480698-0 CBI #39-7153-9 SOCKET TERMINALS 350550-1 CBI #39-7155-3</p> 
1	GND	GROUND																																																	
2	09W	DOOR CLOSE																																																	
3	09Y	DOOR OPEN																																																	
4	10R	DOOR POWER																																																	
1		NOT USED																																																	
2	18W	REVERSE LIGHTS																																																	
3	18Y	LEFT TURN																																																	
4	09N	MARKER LIGHTS																																																	
5	18R	RIGHT TURN																																																	
6	09B	BRAKE LIGHTS																																																	
1		NOT USED																																																	
2	18W	REVERSE LIGHTS																																																	
3	18Y	LEFT TURN																																																	
4	09N	MARKER LIGHTS																																																	
5	18R	RIGHT TURN																																																	
6	09B	BRAKE LIGHTS																																																	
<p>L 915-QE 19P DOOR OPEN SIG GND GROUND</p>  <p>SPEAKER TERMINAL MOLEX TERM. TAPE QV-DIS FEM F/INS 16-1423 CBI #39-4426-1</p>	<p>CAP CONNECTOR AMP 1-480705-0 CBI #39-7154-5 SOCKET TERMINALS 350550-1 CBI #39-7155-3</p> 																																																		
<p>L 906 10 LIFT DOOR AJAR 08T LIFT LIGHTS</p>  <p>SPEAKER TERMINAL MOLEX TERM. TAPE QV-DIS FEM F/INS 16-1423 CBI #39-4426-1</p>																																																			
<p>C216-18-C 1 08K DOME LIGHTS 2 GND GROUND</p>  <p>CAP CONNECTOR AMP 1-480699-0 CBI #39-7154-3 PIN TERMINALS 350547-1 CBI #39-7155-2</p>																																																			
<p>C128</p> <p>FEMALE CONNECTOR 12010973 CBI #39-7185-5 MALE TERMINAL 12124582-L CBI #39-7096-9 SEAL 12015323-V CBI #39-7098-5</p>  <table border="1"> <tr><td>A</td><td>08T</td><td>LIFT LIGHTS</td></tr> <tr><td>B</td><td>GND</td><td>GROUND</td></tr> </table>	A	08T	LIFT LIGHTS	B	GND	GROUND			<p>C137</p> <table border="1"> <tr><td>1</td><td>11R</td><td>RADIO IGN</td></tr> <tr><td>2</td><td>12R</td><td>RADIO MEM</td></tr> <tr><td>3</td><td>GND</td><td>GROUND</td></tr> <tr><td>4</td><td></td><td>NOT USED</td></tr> <tr><td>5</td><td>28W</td><td>LF SPKR +</td></tr> <tr><td>6</td><td>28W/K</td><td>LF SPKR -</td></tr> <tr><td>7</td><td>28E</td><td>RF SPKR +</td></tr> <tr><td>8</td><td>28E/K</td><td>RF SPKR -</td></tr> <tr><td>9</td><td>28P</td><td>RR SPKR +</td></tr> <tr><td>10</td><td>28P/K</td><td>RR SPKR -</td></tr> <tr><td>11</td><td>28G</td><td>LR SPKR +</td></tr> <tr><td>12</td><td>28G/K</td><td>LR SPKR -</td></tr> </table> <p>PLUG CONNECTOR AMP 1-480708-0 CBI #39-7154-7 TERMINALS 350550-1 CBI #39-7155-3</p> 	1	11R	RADIO IGN	2	12R	RADIO MEM	3	GND	GROUND	4		NOT USED	5	28W	LF SPKR +	6	28W/K	LF SPKR -	7	28E	RF SPKR +	8	28E/K	RF SPKR -	9	28P	RR SPKR +	10	28P/K	RR SPKR -	11	28G	LR SPKR +	12	28G/K	LR SPKR -						
A	08T	LIFT LIGHTS																																																	
B	GND	GROUND																																																	
1	11R	RADIO IGN																																																	
2	12R	RADIO MEM																																																	
3	GND	GROUND																																																	
4		NOT USED																																																	
5	28W	LF SPKR +																																																	
6	28W/K	LF SPKR -																																																	
7	28E	RF SPKR +																																																	
8	28E/K	RF SPKR -																																																	
9	28P	RR SPKR +																																																	
10	28P/K	RR SPKR -																																																	
11	28G	LR SPKR +																																																	
12	28G/K	LR SPKR -																																																	
<p>C169 18W REVERSE LIGHTS GND GROUND</p>  <p>#10 EYE</p>	<p>L 909-13 1 07I EXIT LIGHTS 2 GND GROUND</p> <p>PLUG CONNECTOR AMP 1-480698-0 CBI #39-7153-9 SOCKET TERMINALS 350550-1 CBI #39-7155-3</p> 																																																		



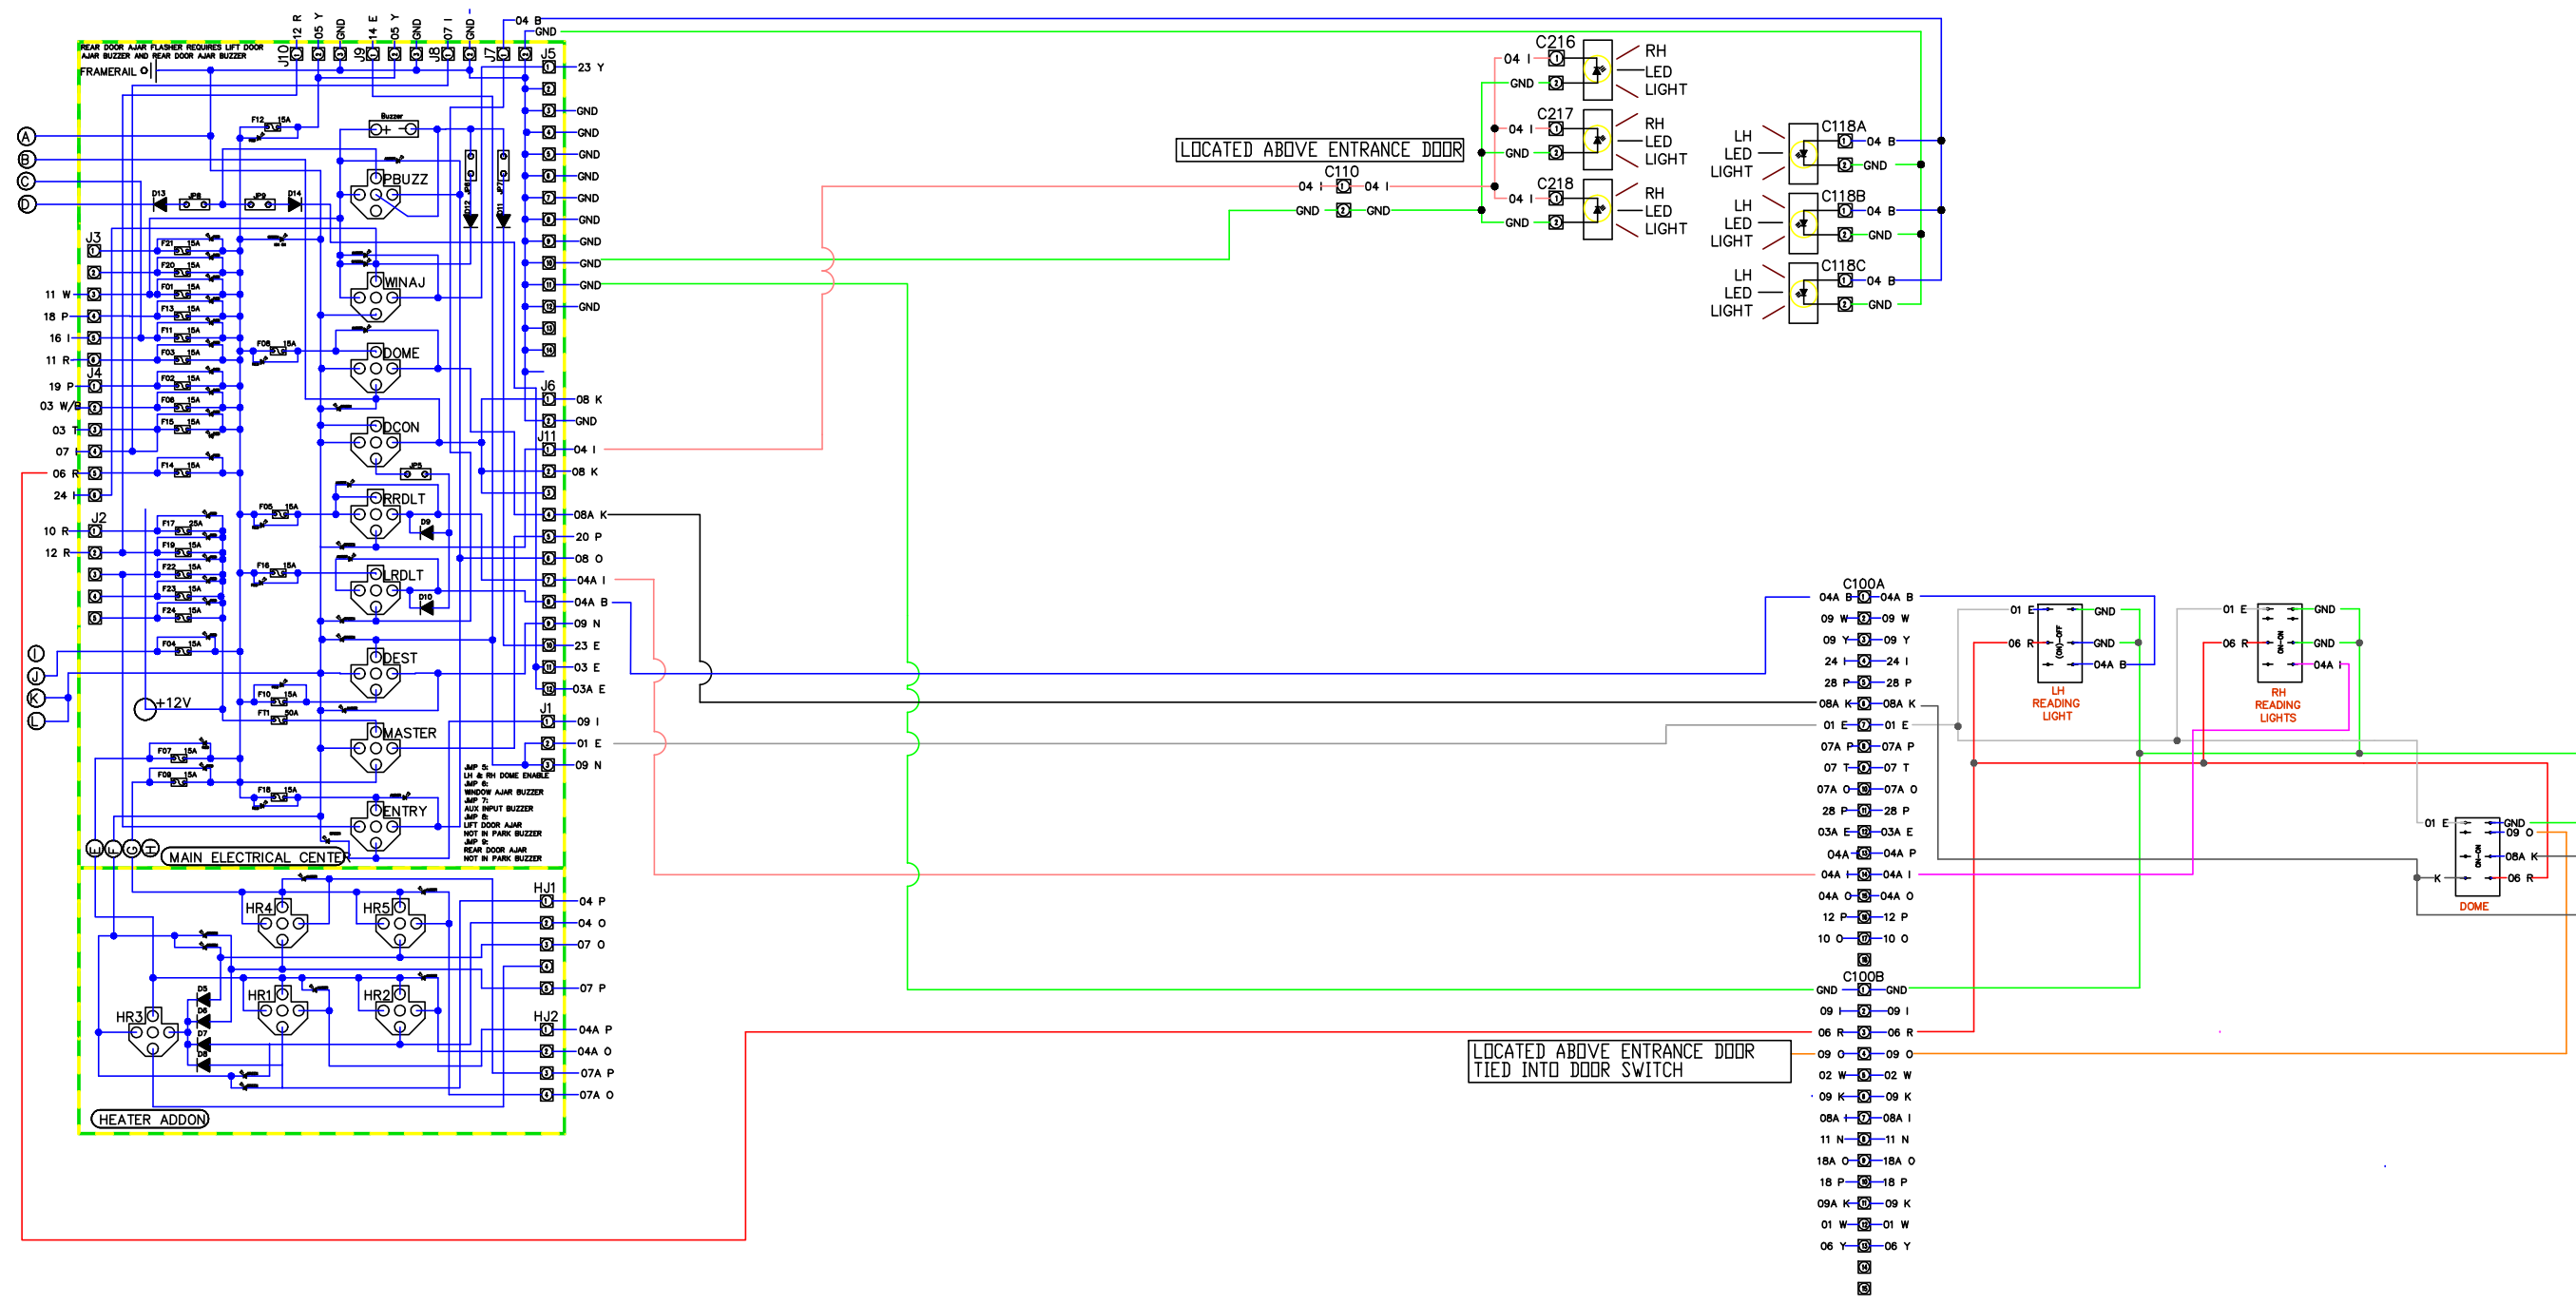


INTERIOR LIGHTING


DATE		ERN	DESCRIPTION OF CHANGES	BY	DATE	ERN	DESCRIPTION OF CHANGES	BY	CHAMPION BUS INC. a TECUMSEH company		APPROVED BY: DD P/N: M DO NOT SCALE: N/A SCALE: N/A	ERN#: LB DRAWN BY: PDOT CUSTOMER: PDOT	TITLE: ASBUILT GMT610 ANALOG MODEL: GMT610	REFERENCE DWG: GMT610 DWG. NO.: SHEET OF 5/11/12 RELEASE DATE: 5/11/12	CBI UNIT NUMBERS:
------	--	-----	------------------------	----	------	-----	------------------------	----	--	--	--	---	---	--	-------------------

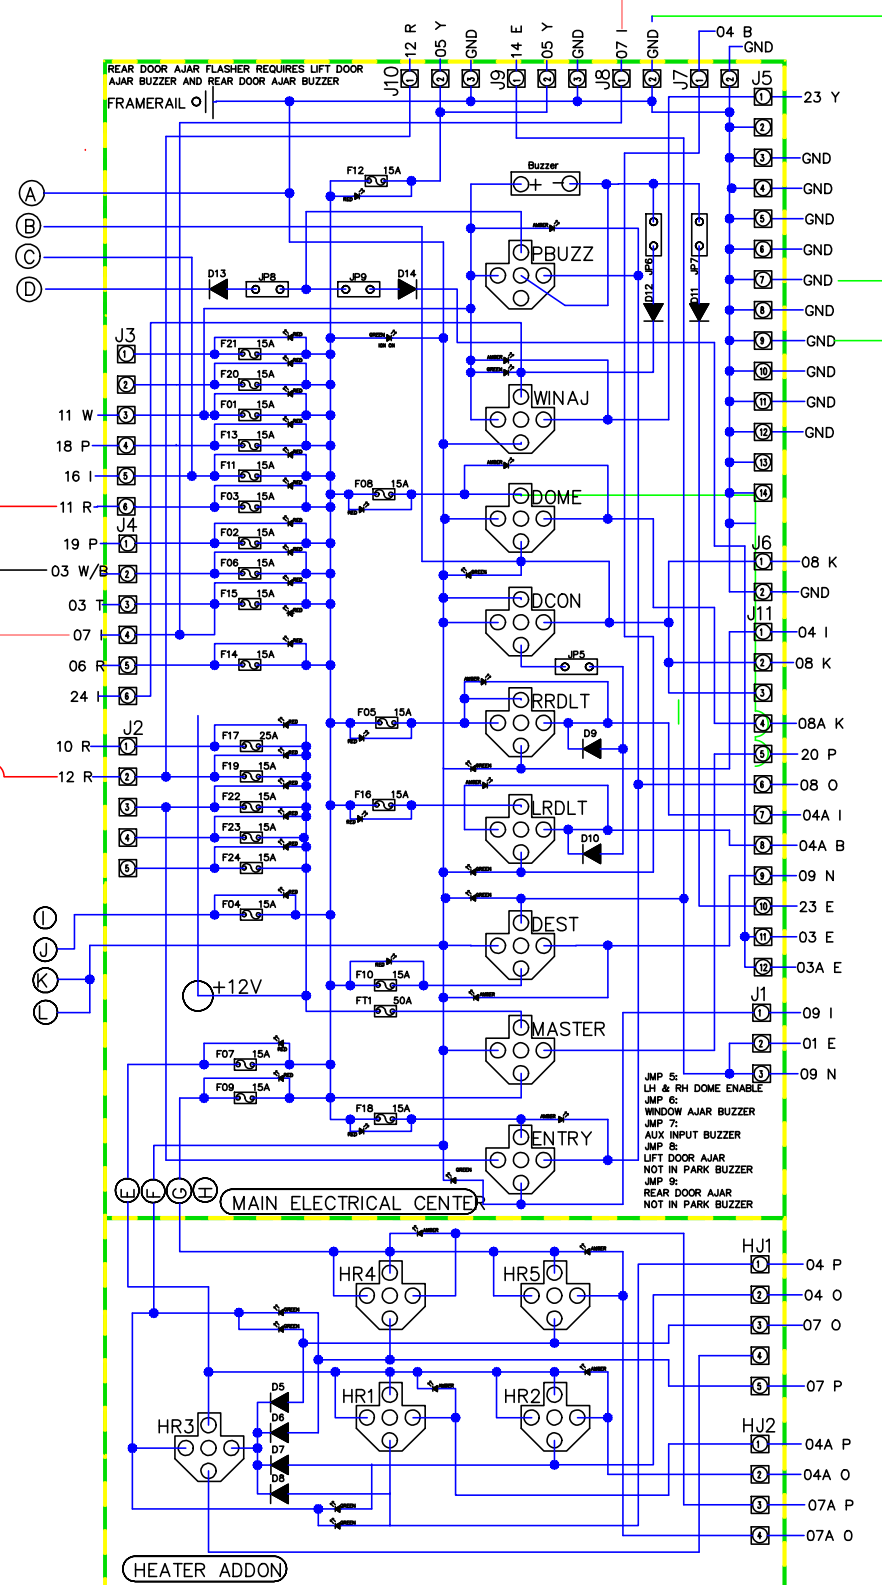

LOCATED BEHIND MAIN PANEL
TOWARD ROADSIDE LIGHTBAR

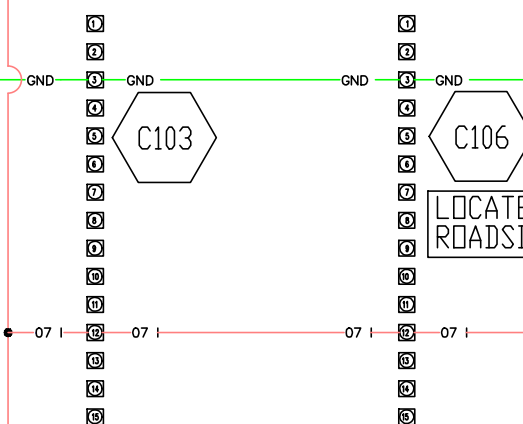

LOCATED ABOVE ENTRANCE DOOR
TOWARD CURBSIDE LIGHTBAR


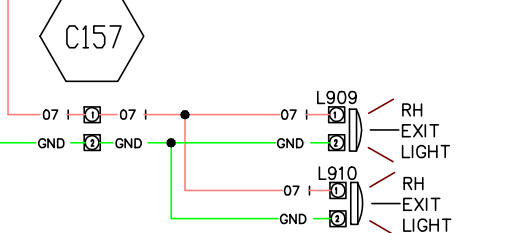


APADS CONNECTION POINT
LOCATED IN FRONT OF PANEL


TO THE 15A IGN WIRE FROM ACC

10/WHITE/IGN

R - +12V IGNITION / SWITCHED	11 R
Y - +12V BATTERY / CONSTANT	12 R
K - CHASSIS GROUND	
NO CONNECTION	
W/K - LF SPEAKER (+)	
W/K - LF SPEAKER (-)	
E - RF SPEAKER (+)	
E/K - RF SPEAKER (-)	
P - RR SPEAKER (+)	
P/K - RR SPEAKER (-)	
G - LR SPEAKER (+)	
G/K - LR SPEAKER (-)	

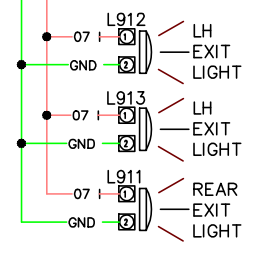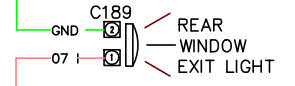

IGNITION CONTROLLED CIRCUITS

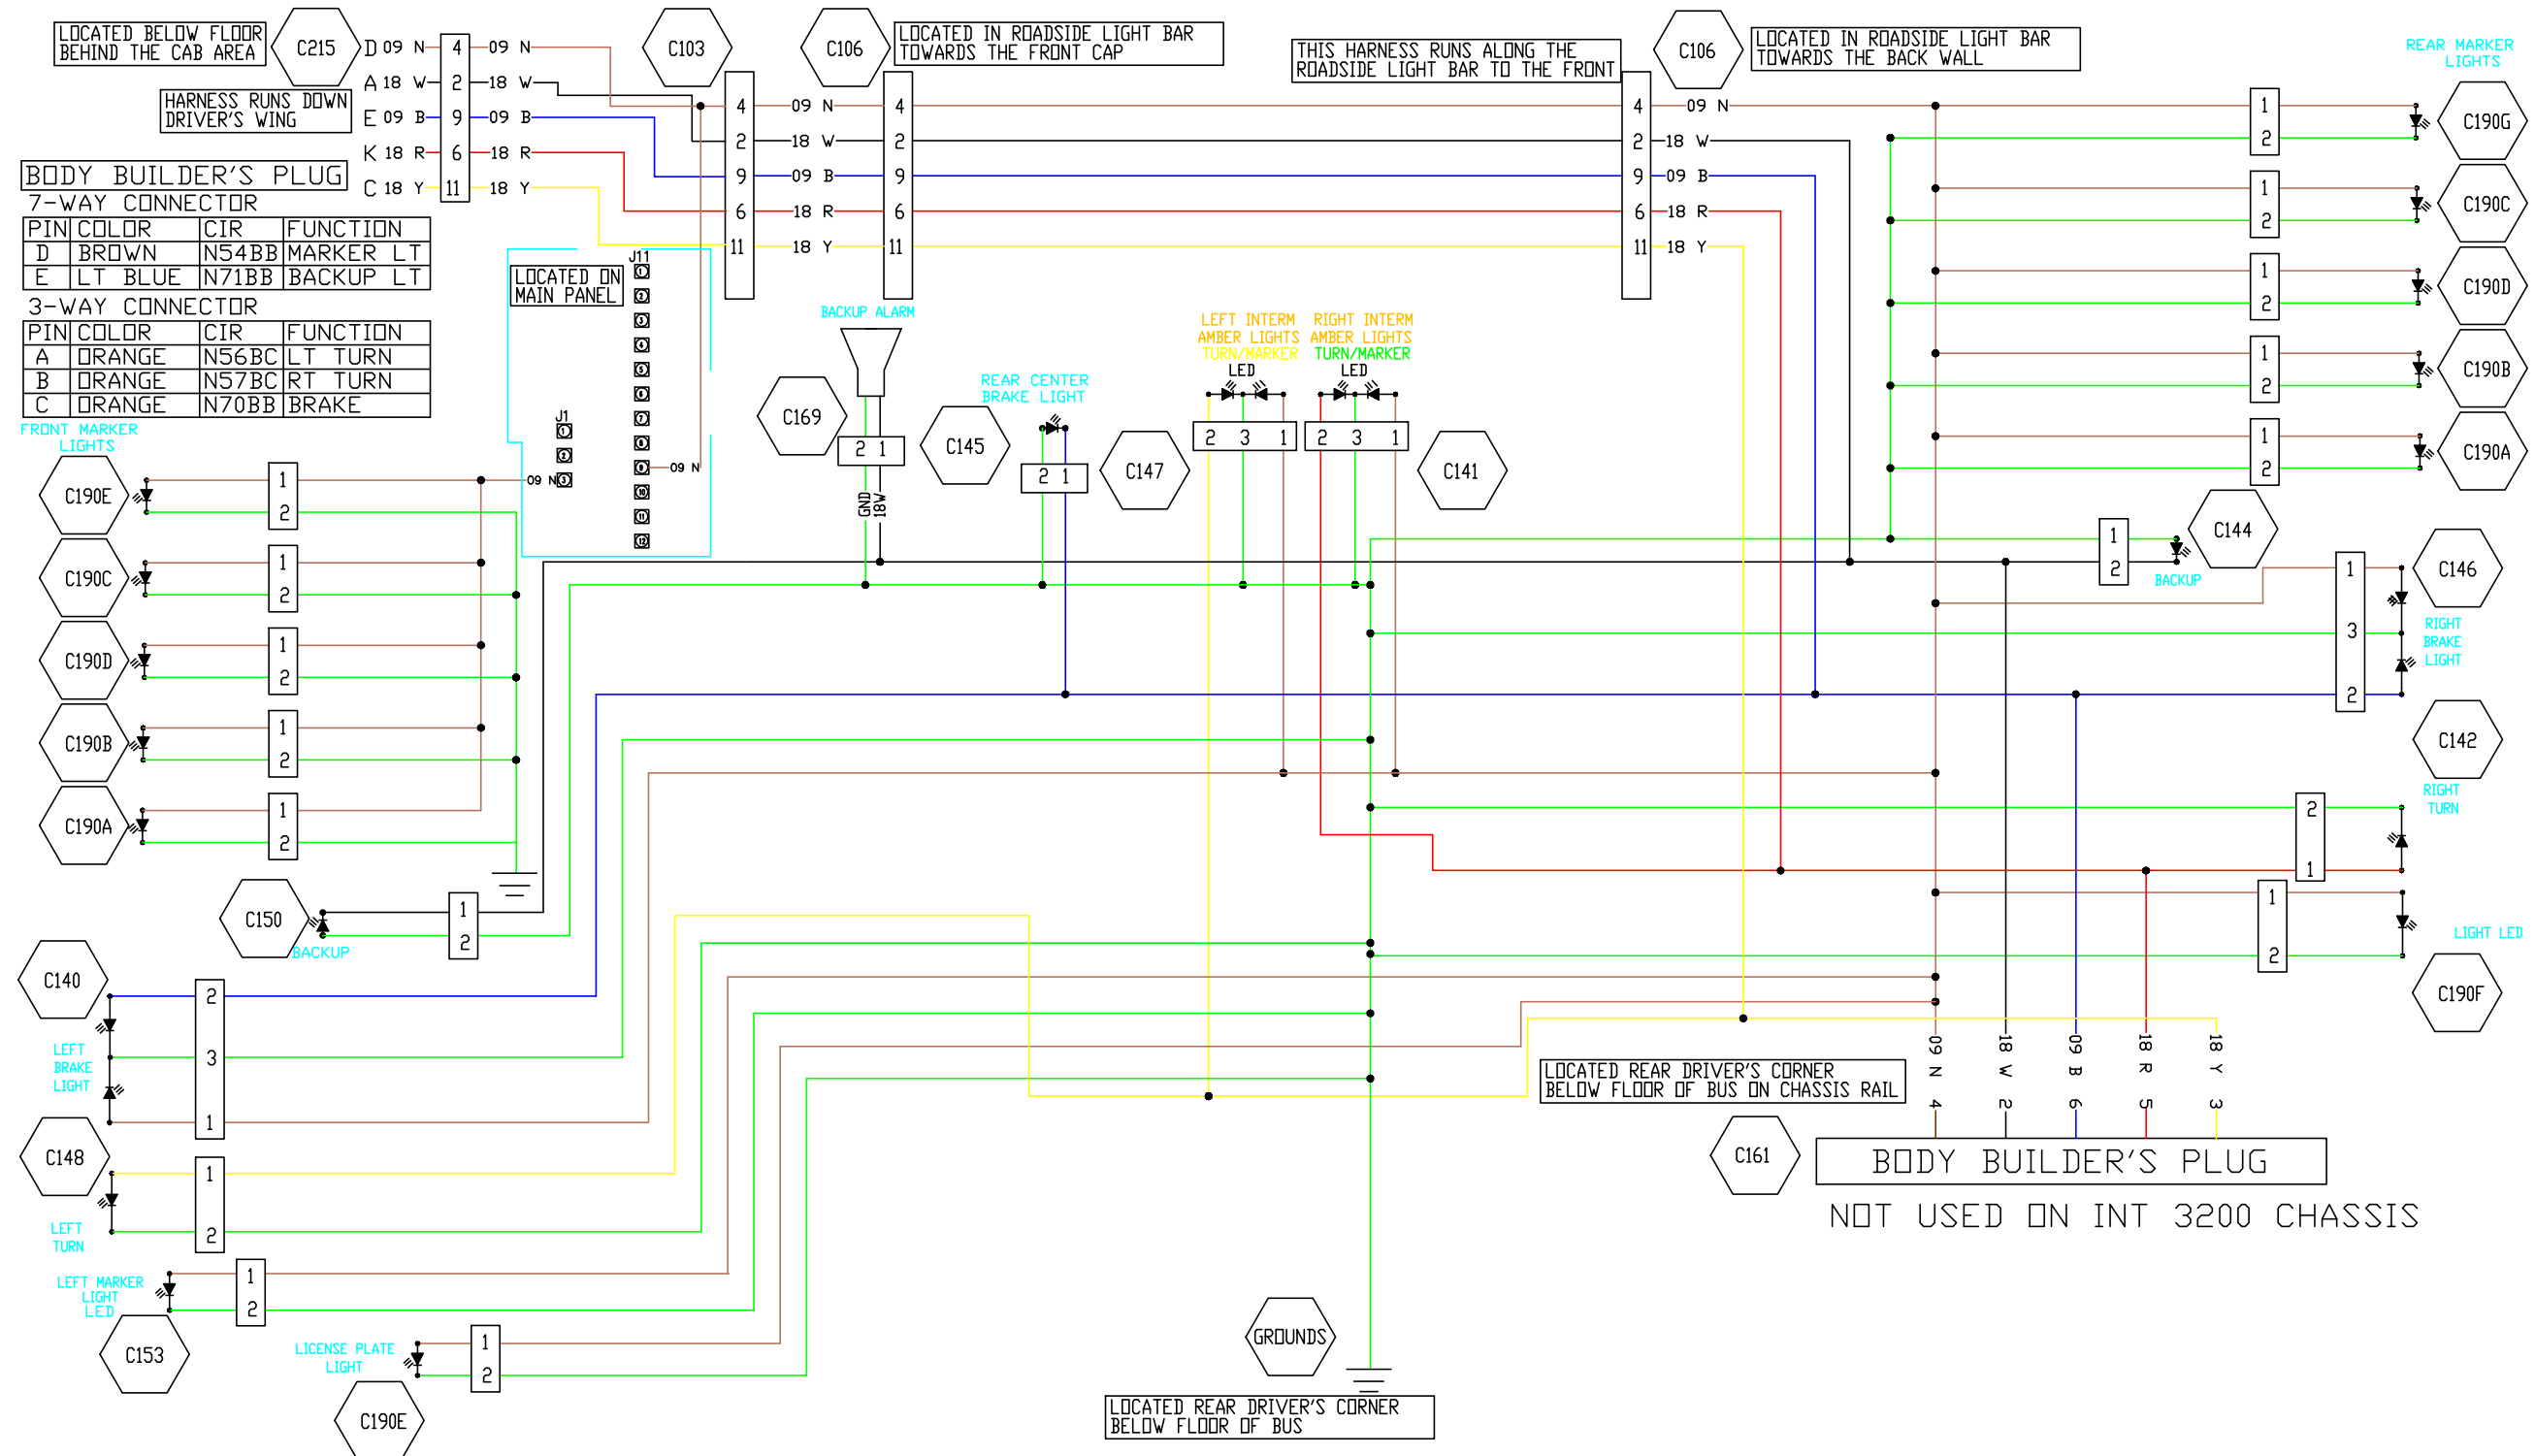

LOCATED BELOW FLOOR BEHIND THE CAB AREA

HARNESS RUNS DOWN DRIVER'S WING

LOCATED ON MAIN PANEL

LOCATED IN ROADSIDE LIGHT BAR TOWARDS THE FRONT

THIS HARNESS RUNS ALONG THE ROADSIDE LIGHT BAR TO THE FRONT

LOCATED IN ROADSIDE LIGHT BAR TOWARDS THE BACK WALL




BODY BUILDER'S PLUG 7-WAY CONNECTOR

PIN	COLOR	CIR	FUNCTION
D	BROWN	N54BB	MARKER LT
E	LT BLUE	N71BB	BACKUP LT

3-WAY CONNECTOR

PIN	COLOR	CIR	FUNCTION
A	ORANGE	N56BC	LT TURN
B	ORANGE	N57BC	RT TURN
C	ORANGE	N70BB	BRAKE


FRONT MARKER LIGHTS

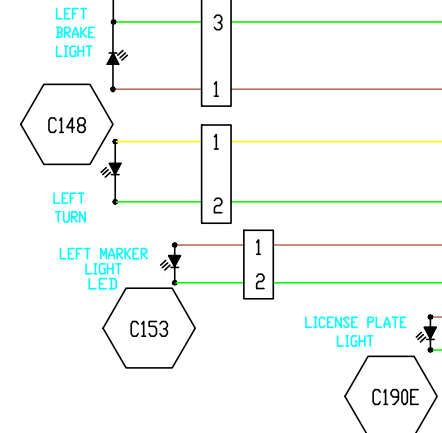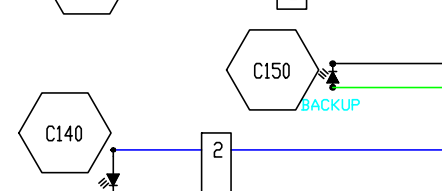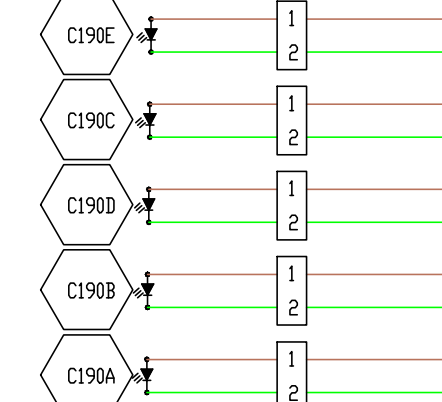

LOCATED REAR DRIVER'S CORNER BELOW FLOOR OF BUS ON CHASSIS RAIL


BODY BUILDER'S PLUG NOT USED ON INT 3200 CHASSIS

EXTERIOR LIGHTING

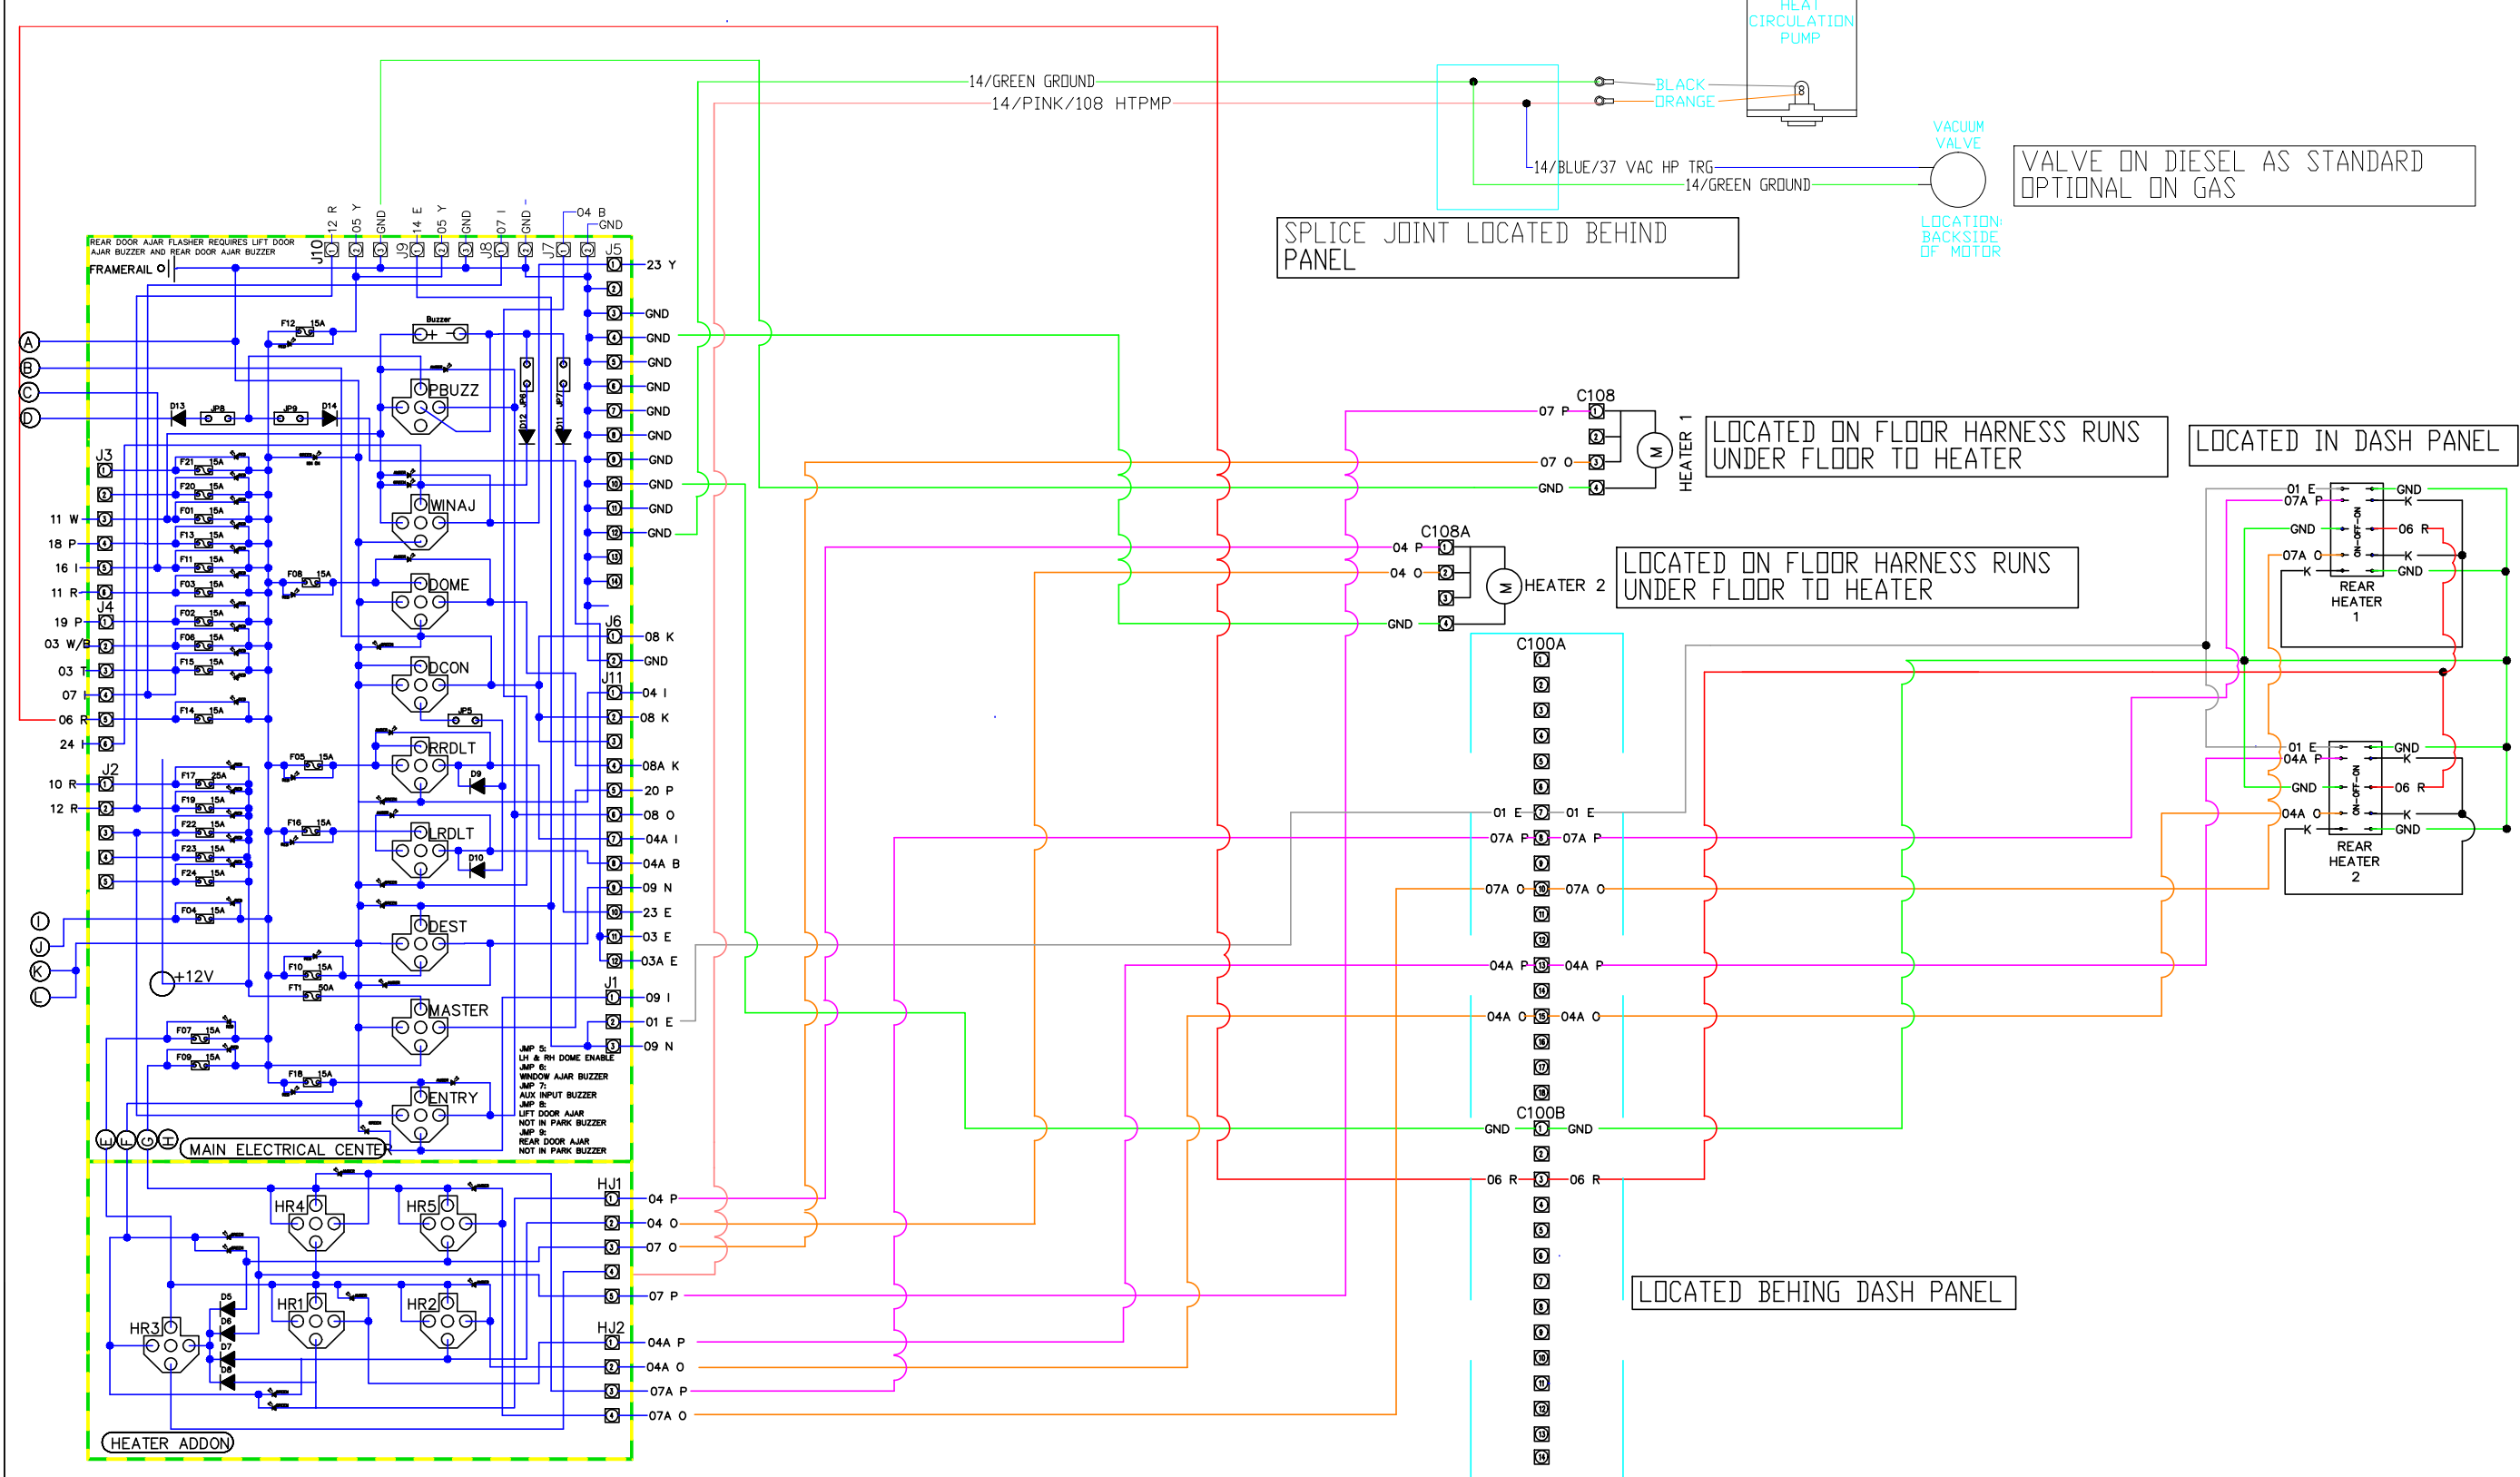


AUXILARY HEATING SYSTEM

DATE		ERN	DESCRIPTION OF CHANGES	BY	DATE	ERN	DESCRIPTION OF CHANGES	BY	 CHAMPION BUS INC. <small>a TECUMSEH company</small>	APPROVED BY: DD P/ME: M DO NOT SCALE: N/A SCALE: N/A	ERN#: LB DRAWN BY: CUSTOMER: PDDT	TITLE: ASBUILT GMT610 ANALOG MODEL: GMT610	REFERENCE DWG: GMT610 DWG. NO.: SHEET 1 OF 1 RELEASE DATE: 5/11/12	CBI UNIT NUMBERS:
------	--	-----	------------------------	----	------	-----	------------------------	----	---	---	--------------------------------------	---	---	-------------------

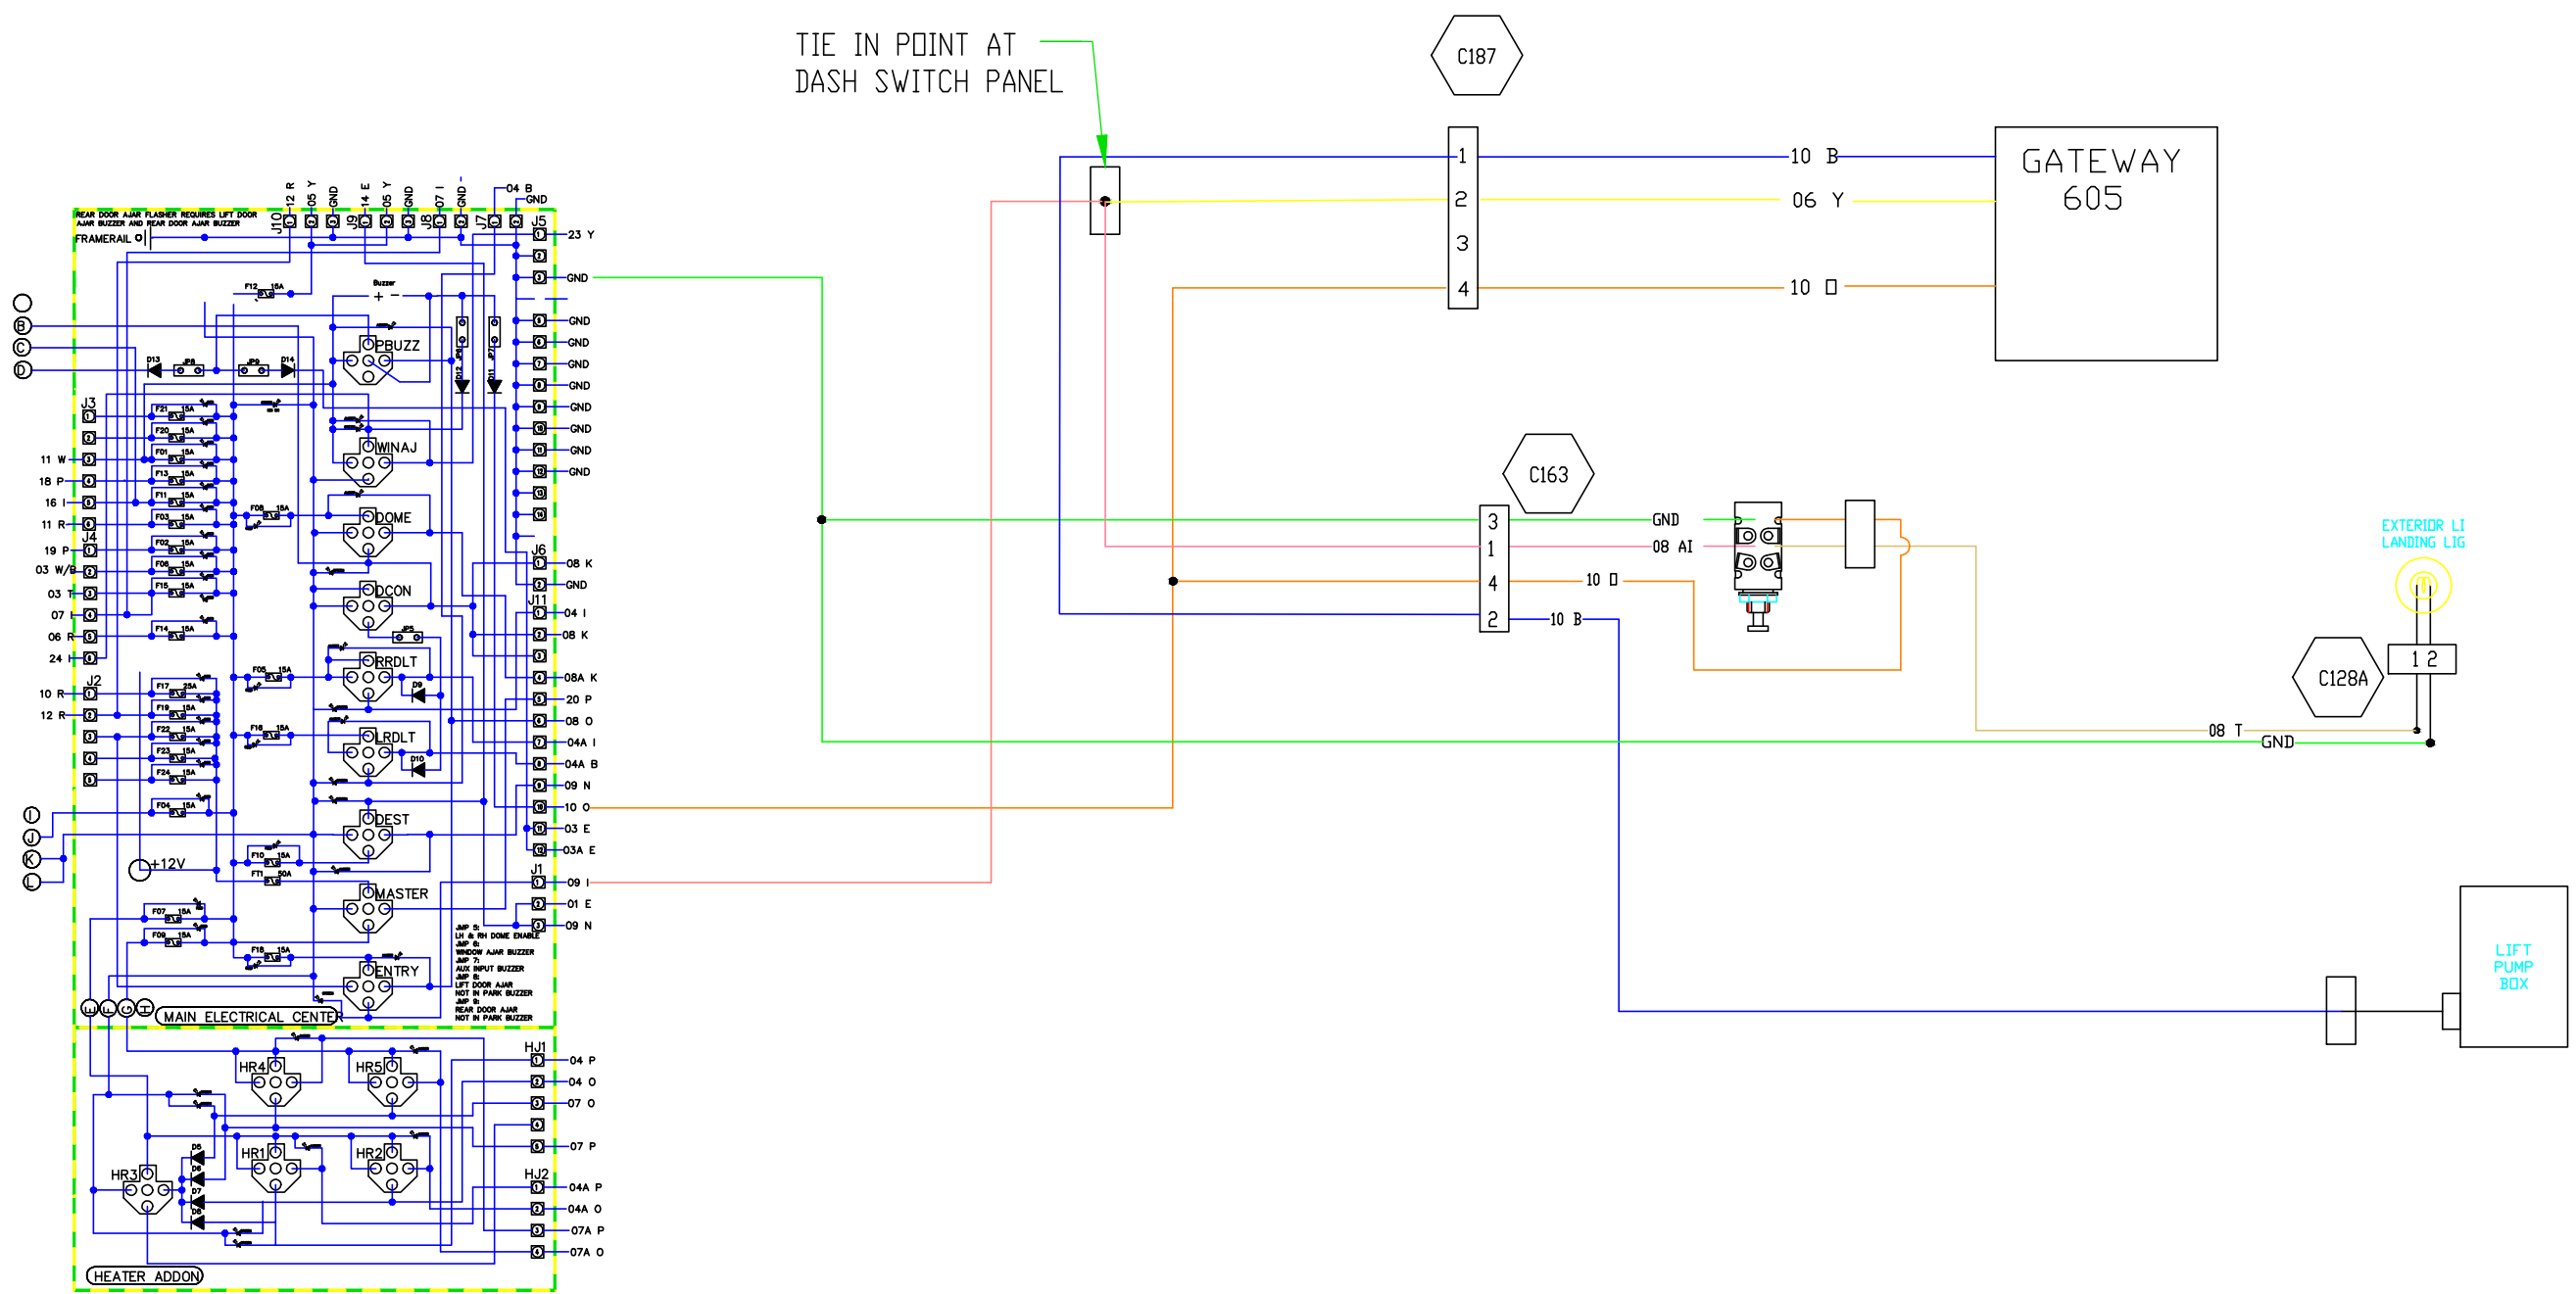


LIFT SYSTEM

												APPROVED BY: DD	ERN#:	TITLE: ASBUILTS GMT610 ANALOG	REFERENCE DWG: GMT610
R DATE	ERN	DESCRIPTION OF CHANGES	BY	R DATE	ERN	DESCRIPTION OF CHANGES	BY	DO NOT SCALE SCALE: N/A	DRAWN BY: CUSTOMER: LB PDDT	MODEL: GMT610	DWG. NO. SHEET 1 OF 1	RELEASE DATE: 5/11/12	CBI UNIT NUMBERS:		

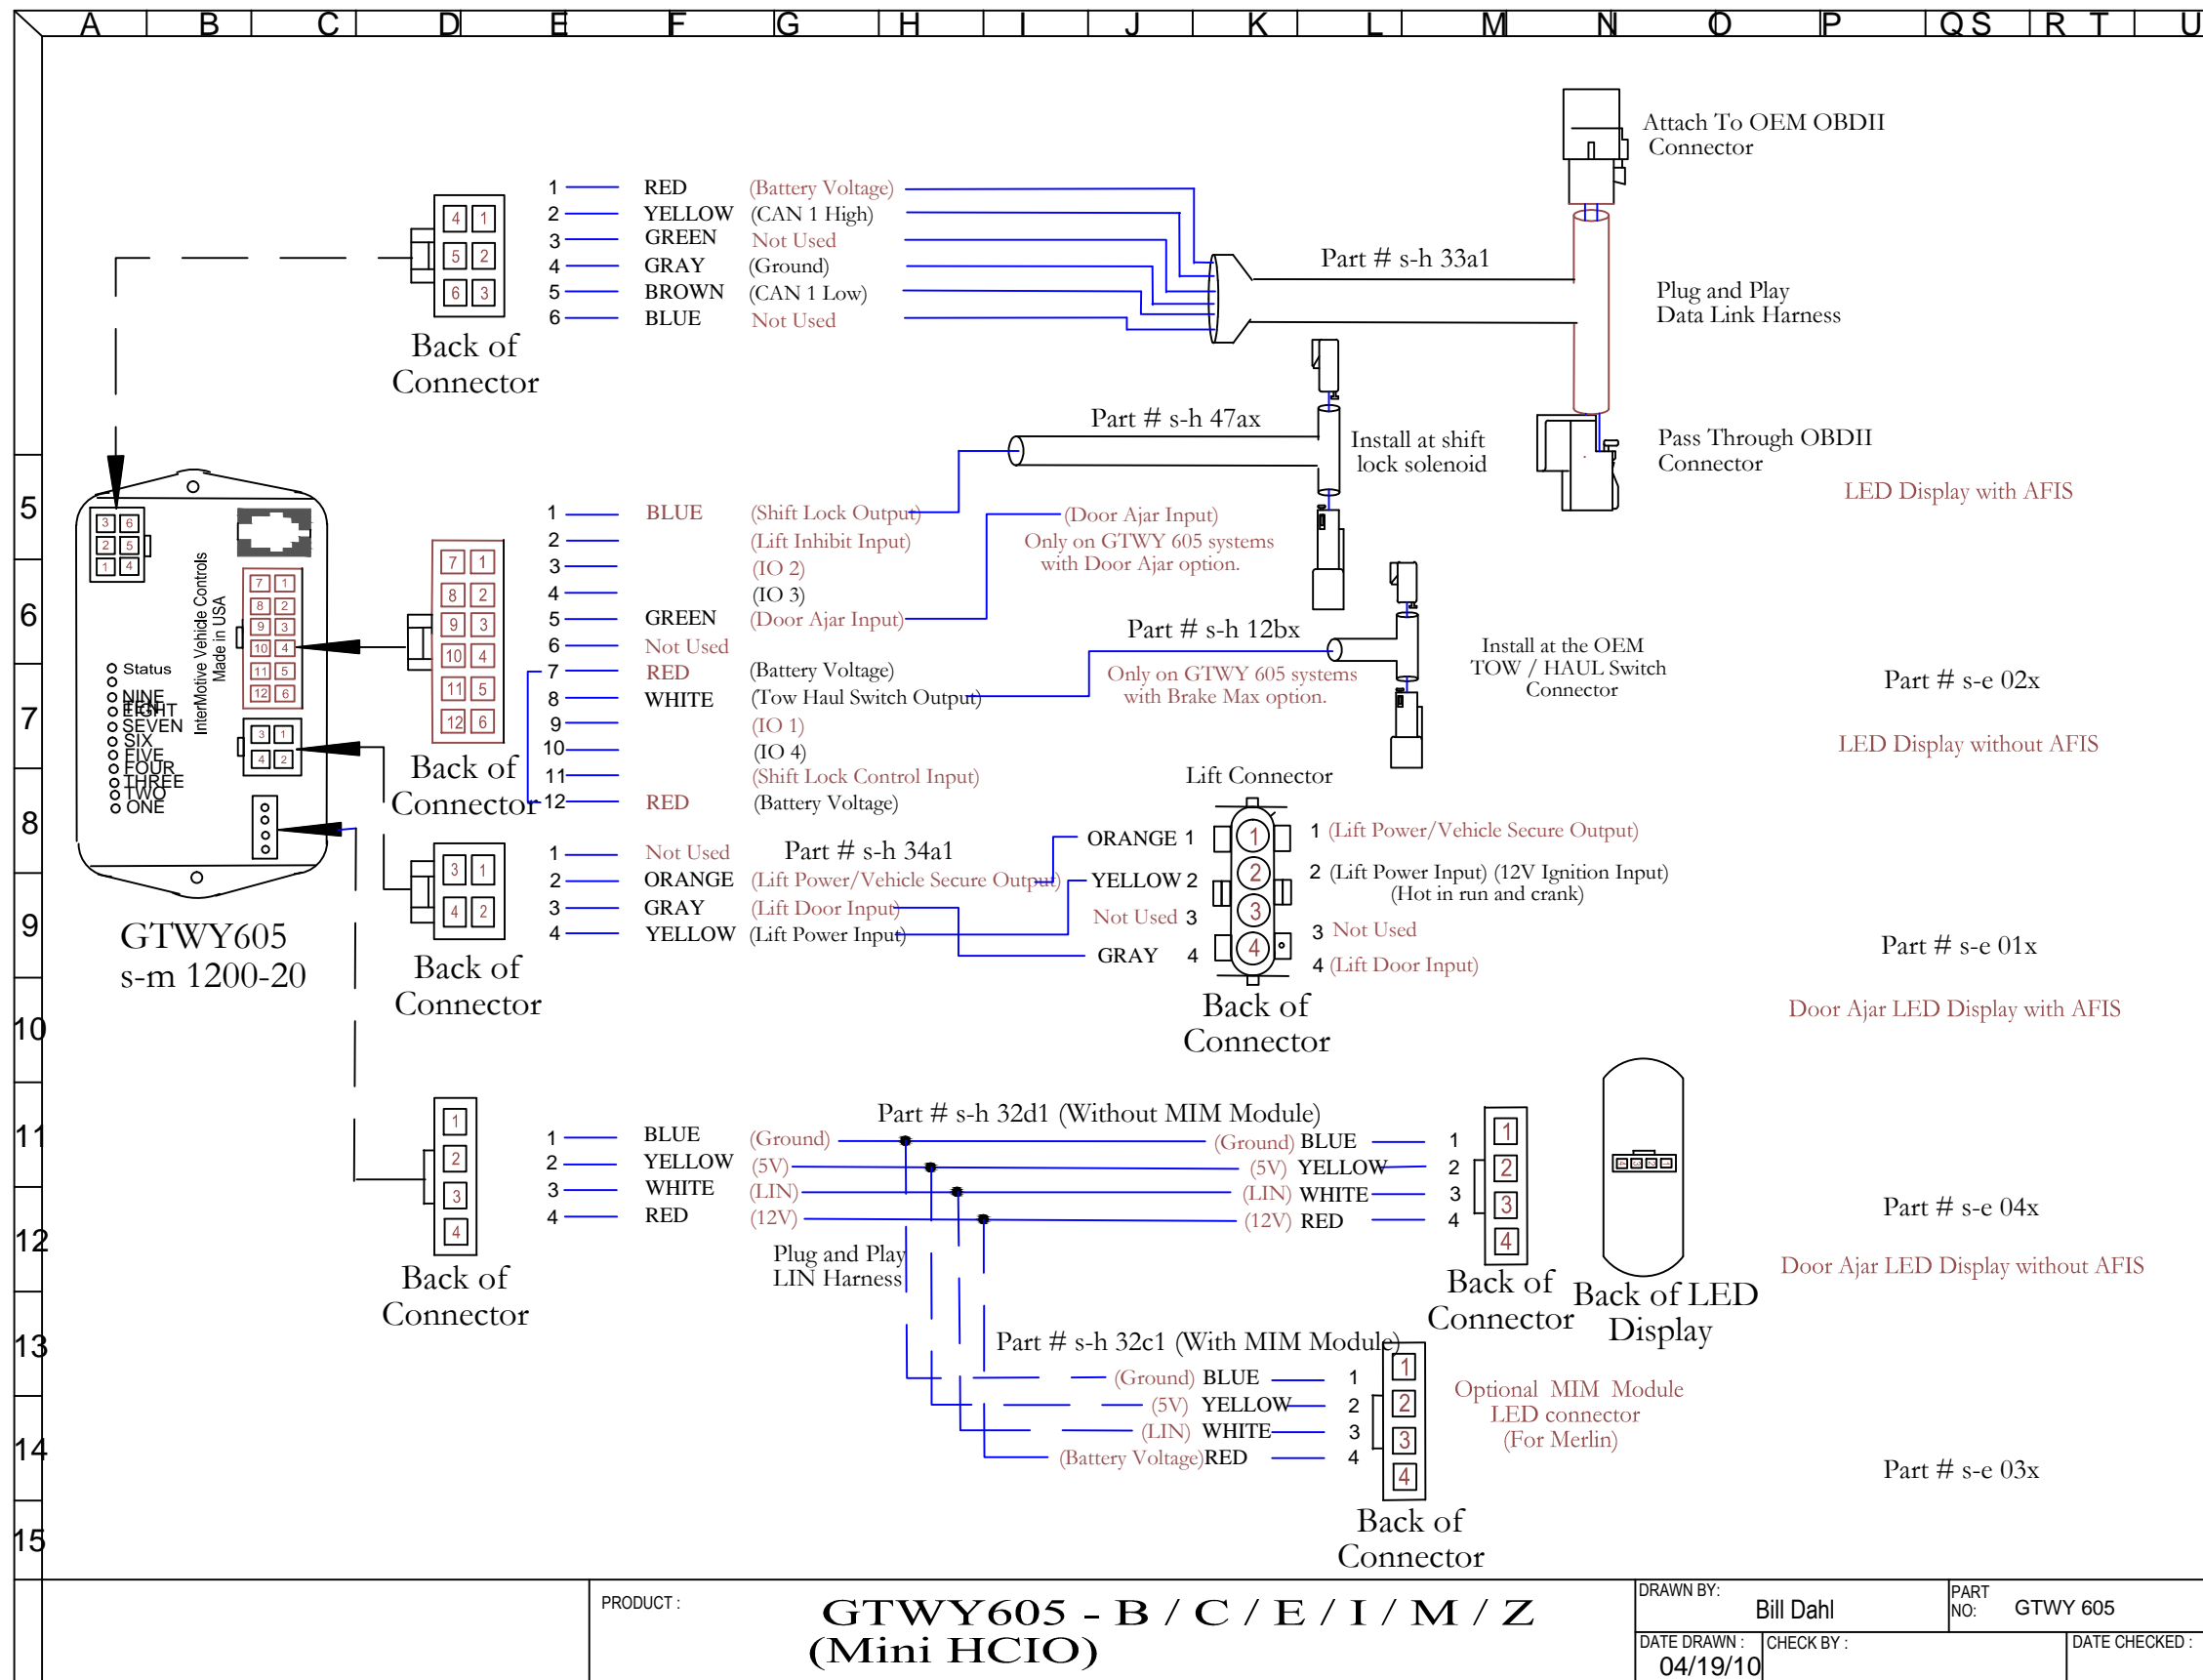

LIFT SYSTEM


DATE		ERN	DESCRIPTION OF CHANGES	BY	DATE	ERN	DESCRIPTION OF CHANGES	BY			APPROVED BY: DD P/LE: M DO NOT SCALE: N/A SCALE: N/A	ERN#: LB DRAWN BY: CUSTOMER: PDDT	TITLE: ASBUILTS GMT610 ANALOG MODEL: GMT610	REFERENCE DWG: GMT610 DWG. NO.: SHEET 1 OF 1	RELEASE DATE: 5/11/12 CBI UNIT NUMBERS:
------	--	-----	------------------------	----	------	-----	------------------------	----	--	--	---	--------------------------------------	--	--	--

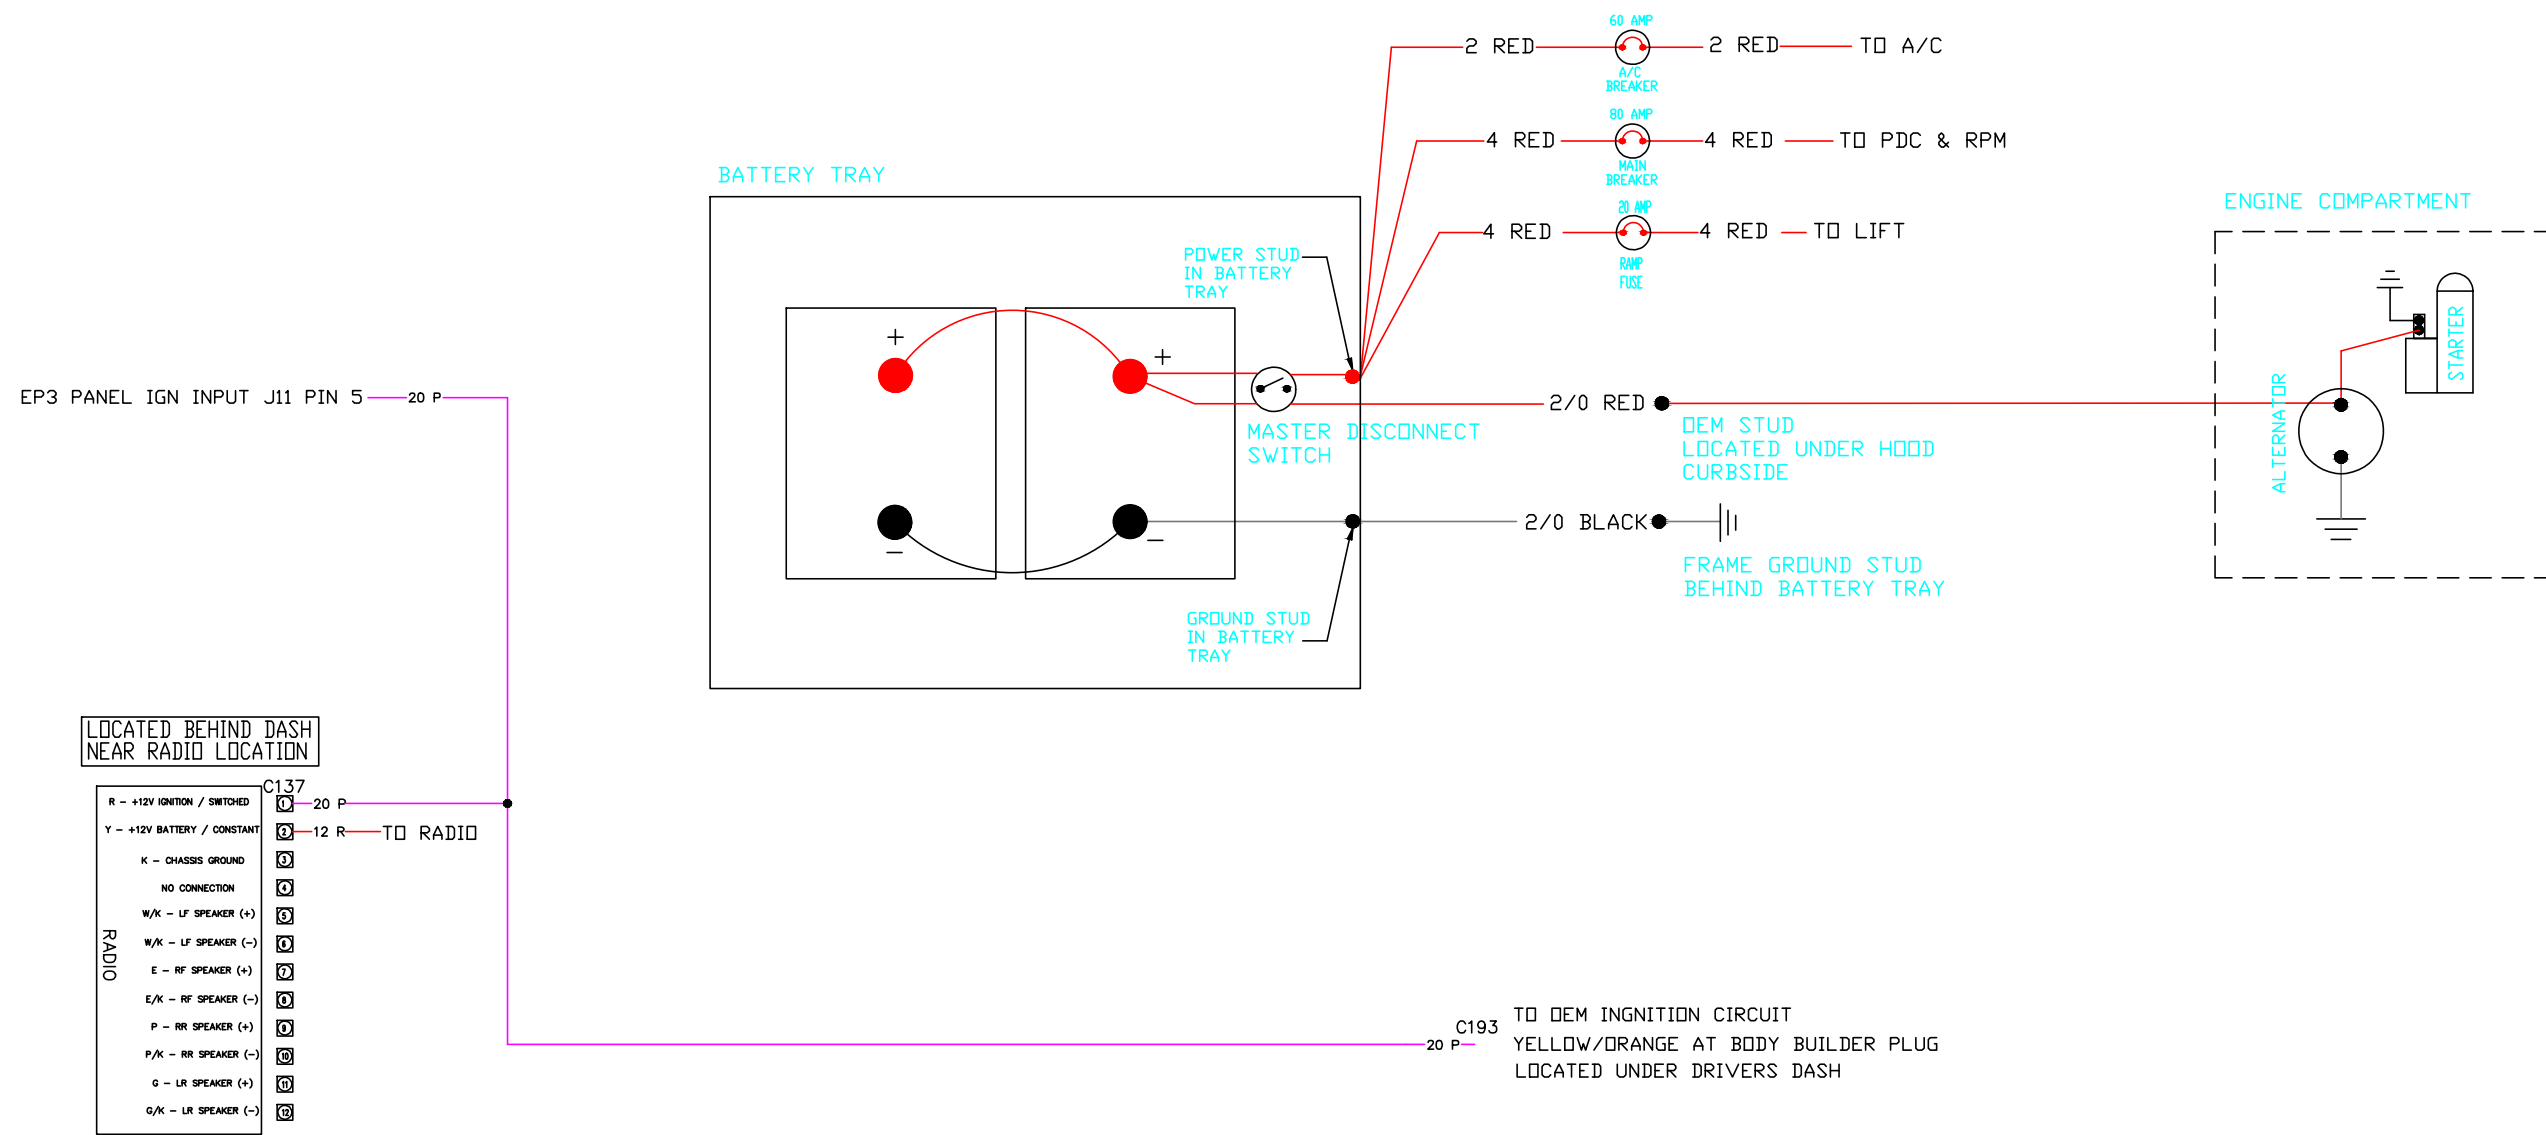

MAIN POWER CONNECTIONS

								APPROVED BY: DD	ERN#:	TITLE: ASBUILT GMT610 ANALOG	REFERENCE DWG: GMT610
P/IE: M	DO NOT SCALE SCALE: N/A	DRAWN BY: CUSTOMER: LB PDDT	MODEL: GMT610	DWG. NO.: SHEET 1 OF 1	RELEASE DATE: 5/11/12	CBI UNIT NUMBERS:					
R DATE ERN	DESCRIPTION OF CHANGES	BY R DATE ERN	DESCRIPTION OF CHANGES	BY R DATE ERN	DESCRIPTION OF CHANGES	BY R DATE ERN	DESCRIPTION OF CHANGES				

STOP REQUEST
SIGN IN FRONT
BULKHEAD

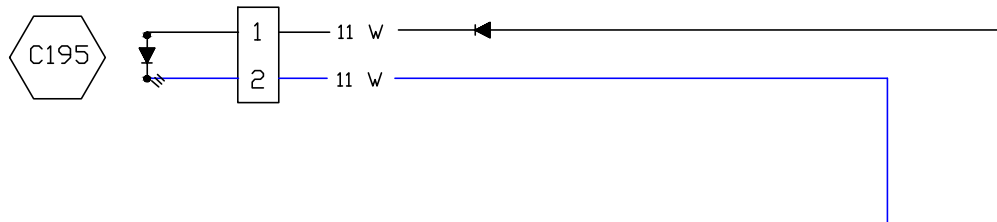

C175 ROADSIDE
PASSENGER ADA
REQUEST BUTTOM




C180 PASSENGER
PULLCORD
SWITCH




C176 CURBSIDE
PASSENGER ADA
REQUEST BUTTOM



C181 CURBSIDE
PULLCORD
SWITCH

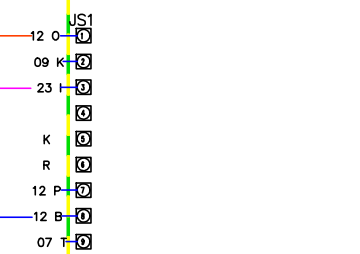


(STOP REQUEST ADDON)

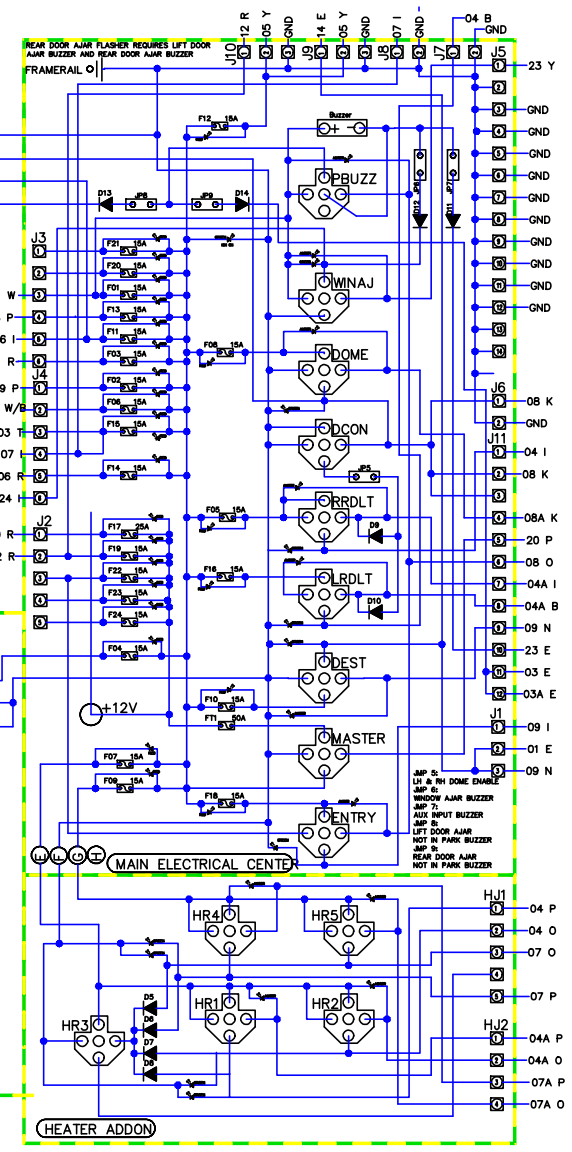

STOP REQUEST


						APPROVED BY: DD	ERN#:	TITLE: ASBUILT GMT610 ANALOG	REFERENCE DWG: GMT610
P/IE: M	DO NOT SCALE SCALE: N/A	DRAWN BY: CUSTOMER: LB PDDT	MODEL: GMT610	DWG. NO.: SHEET 1 OF 1	RELEASE DATE: 5/11/12	CBI UNIT NUMBERS:			
R DATE ERN	DESCRIPTION OF CHANGES	BY R DATE ERN	DESCRIPTION OF CHANGES						

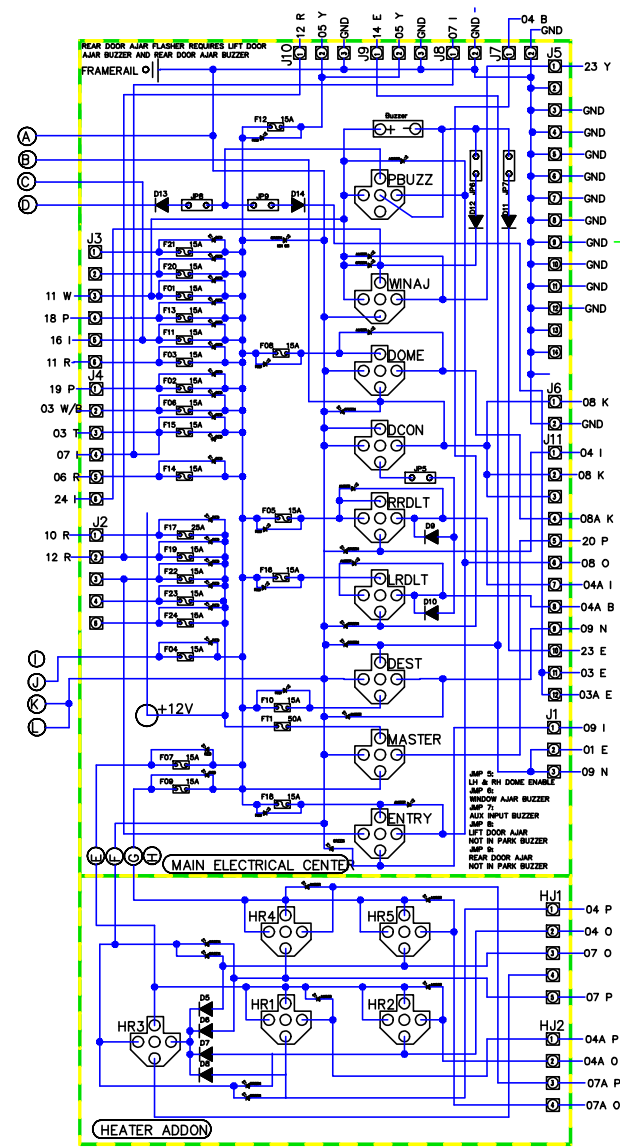



REI RADIO

A4
A7
B6
B7



- R - +12V IGNITION / SWITCHED
- Y - +12V BATTERY / CONSTANT
- K - CHASSIS GROUND
- NO CONNECTION
- W/K - LF SPEAKER (+)
- W/K - LF SPEAKER (-)
- E - RF SPEAKER (+)
- E/K - RF SPEAKER (-)
- P - RR SPEAKER (+)
- P/K - RR SPEAKER (-)
- G - LR SPEAKER (+)
- G/K - LR SPEAKER (-)

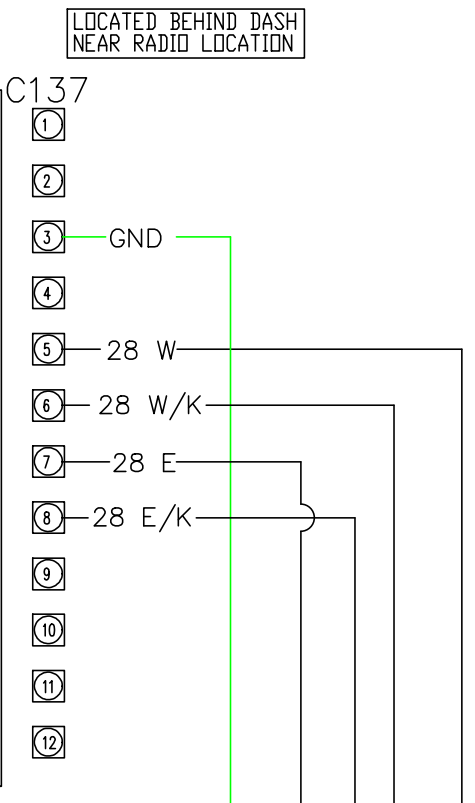


LOCATED BEHIND ELECTRICAL PANEL TOWARD ROADSIDE LIGHTBAR

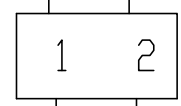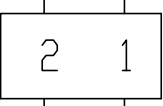

LOCATED ABOVE DOOR HEADER TOWARD CURBSIDE LIGHTBAR

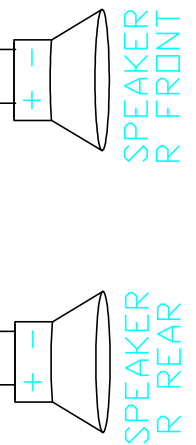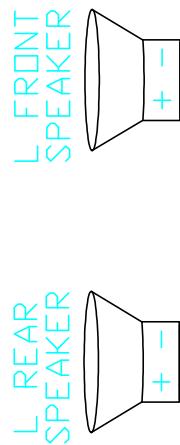


RADIO CONNECTIONS

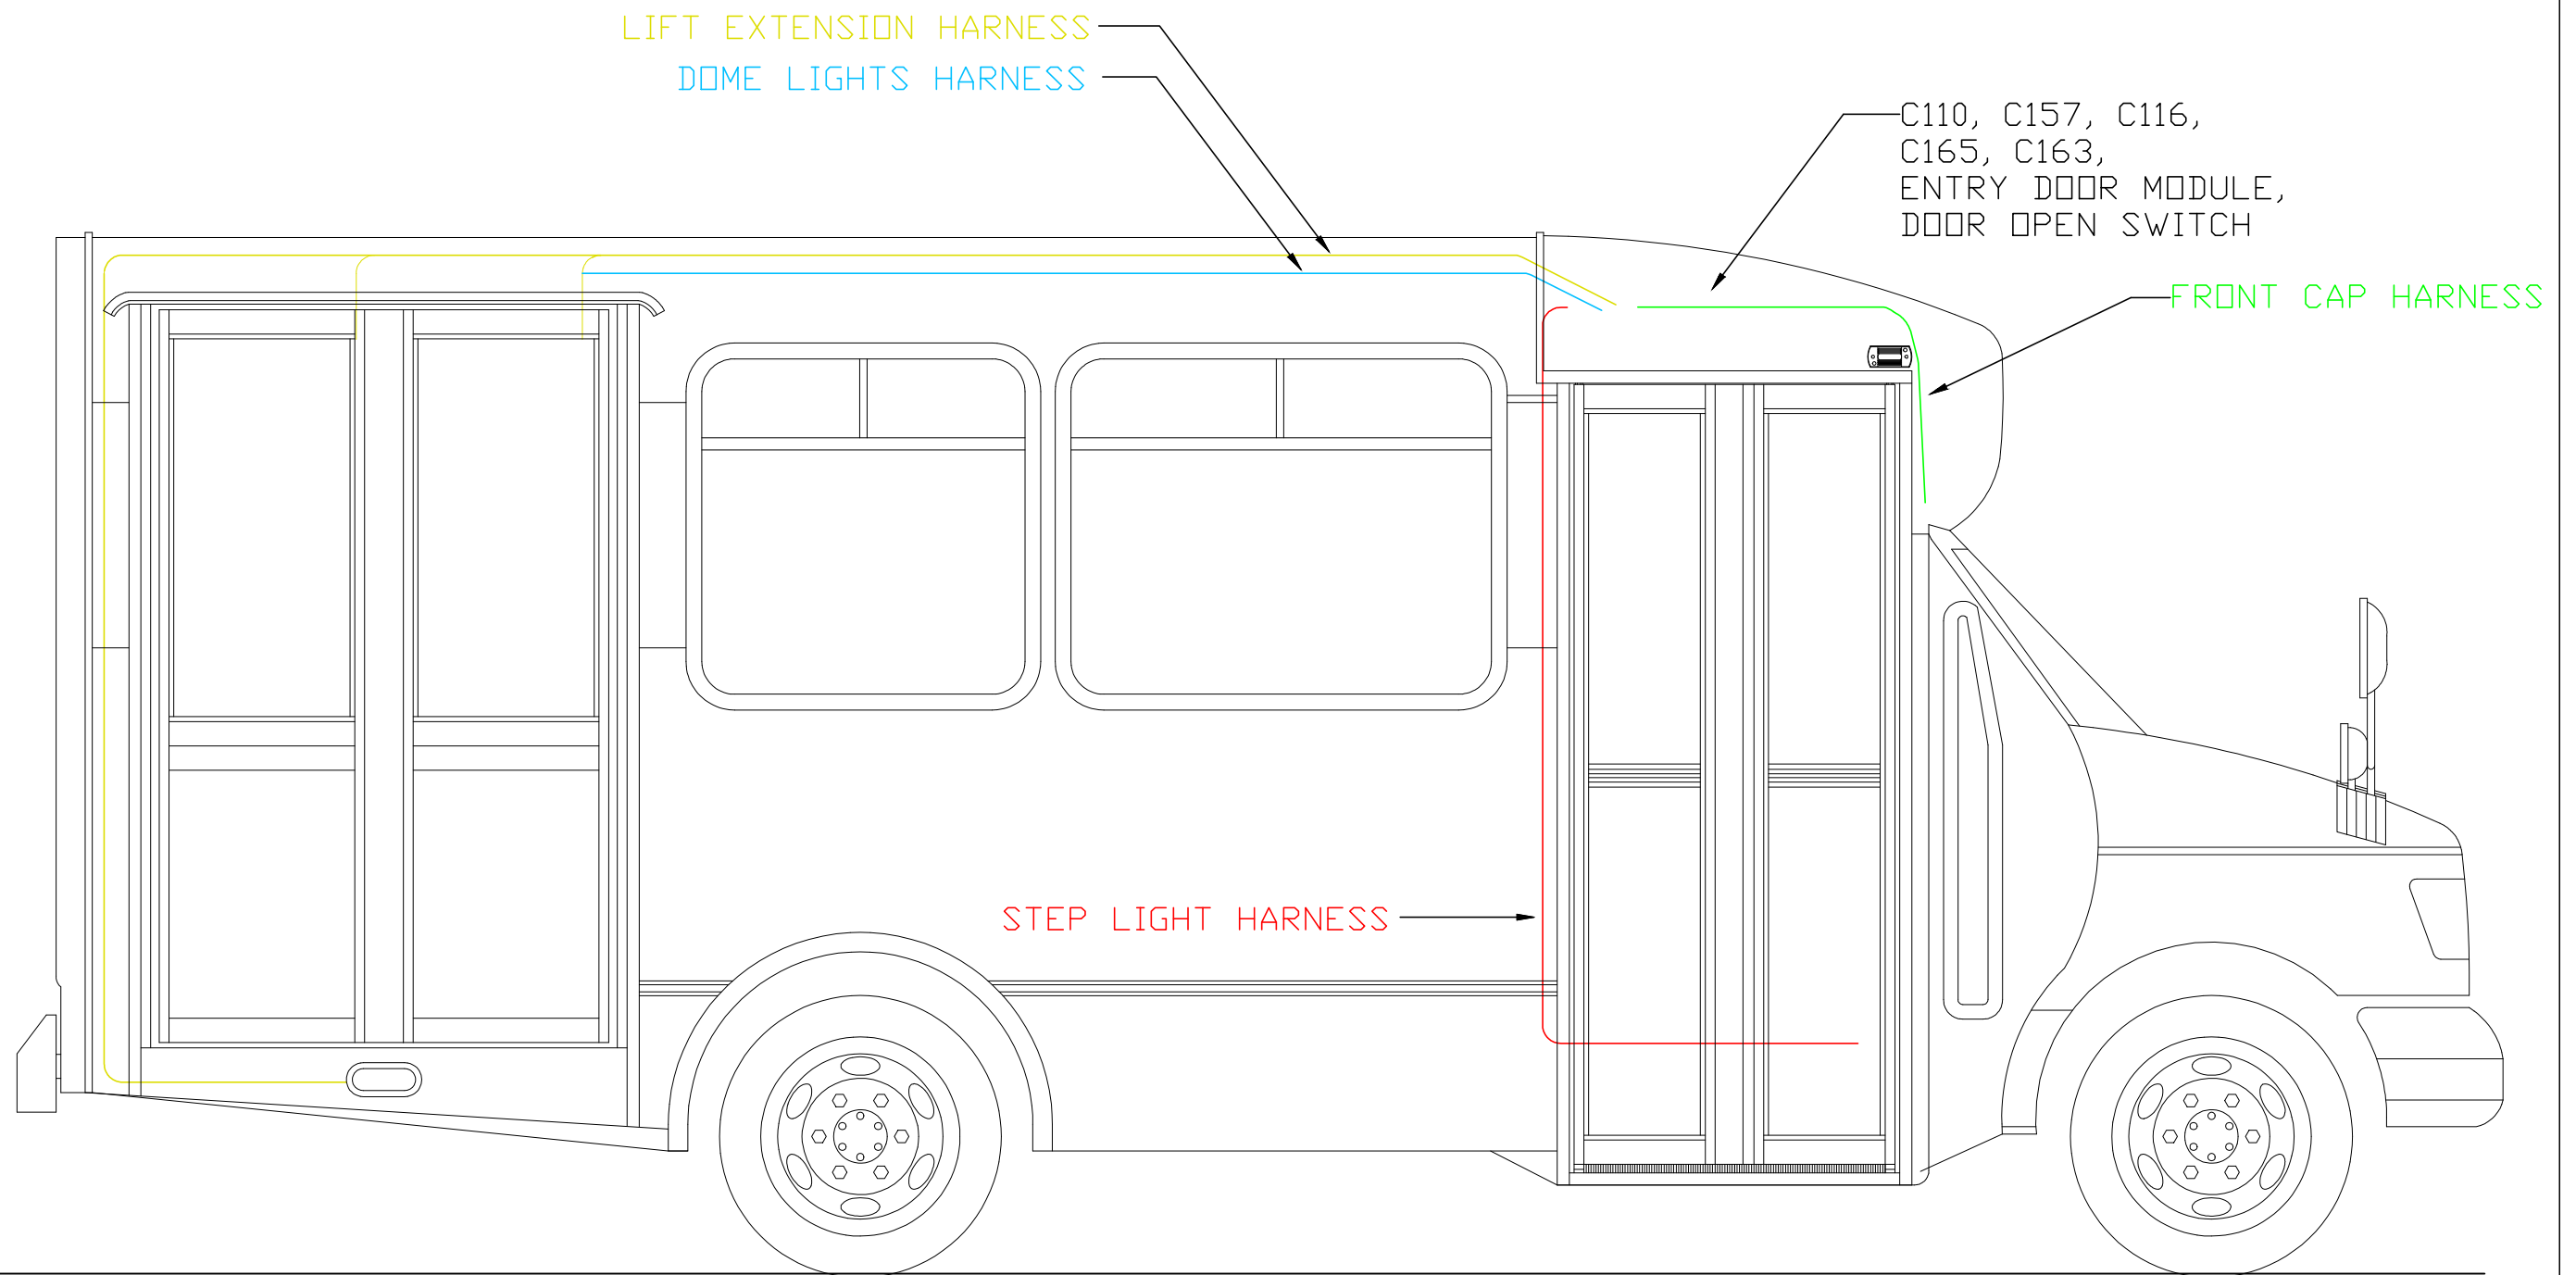


										 CHAMPION BUS INC. — a  company —		APPROVED BY: DD	ERM#: 	TITLE: ASBUILT GMT610 ANALOG	REFERENCE DWG: GMT610
R DATE 	ERN 	DESCRIPTION OF CHANGES 	BY 	R DATE 	ERN 	DESCRIPTION OF CHANGES 	BY 	DO NOT SCALE SCALE: N/A	DRAWN BY: CUSTOMER: LB PDDT	MODEL: GMT610	DWG. NO. SHEET 1 OF 1	RELEASE DATE: 5/11/12	CBI UNIT NUMBERS: 		

C103, C104, C105,
 C108, C109, C124,
 C127, C132, C133,
 C134, C138, C167,
 C174, MAIN, MAIN-2,
 MAIN-3

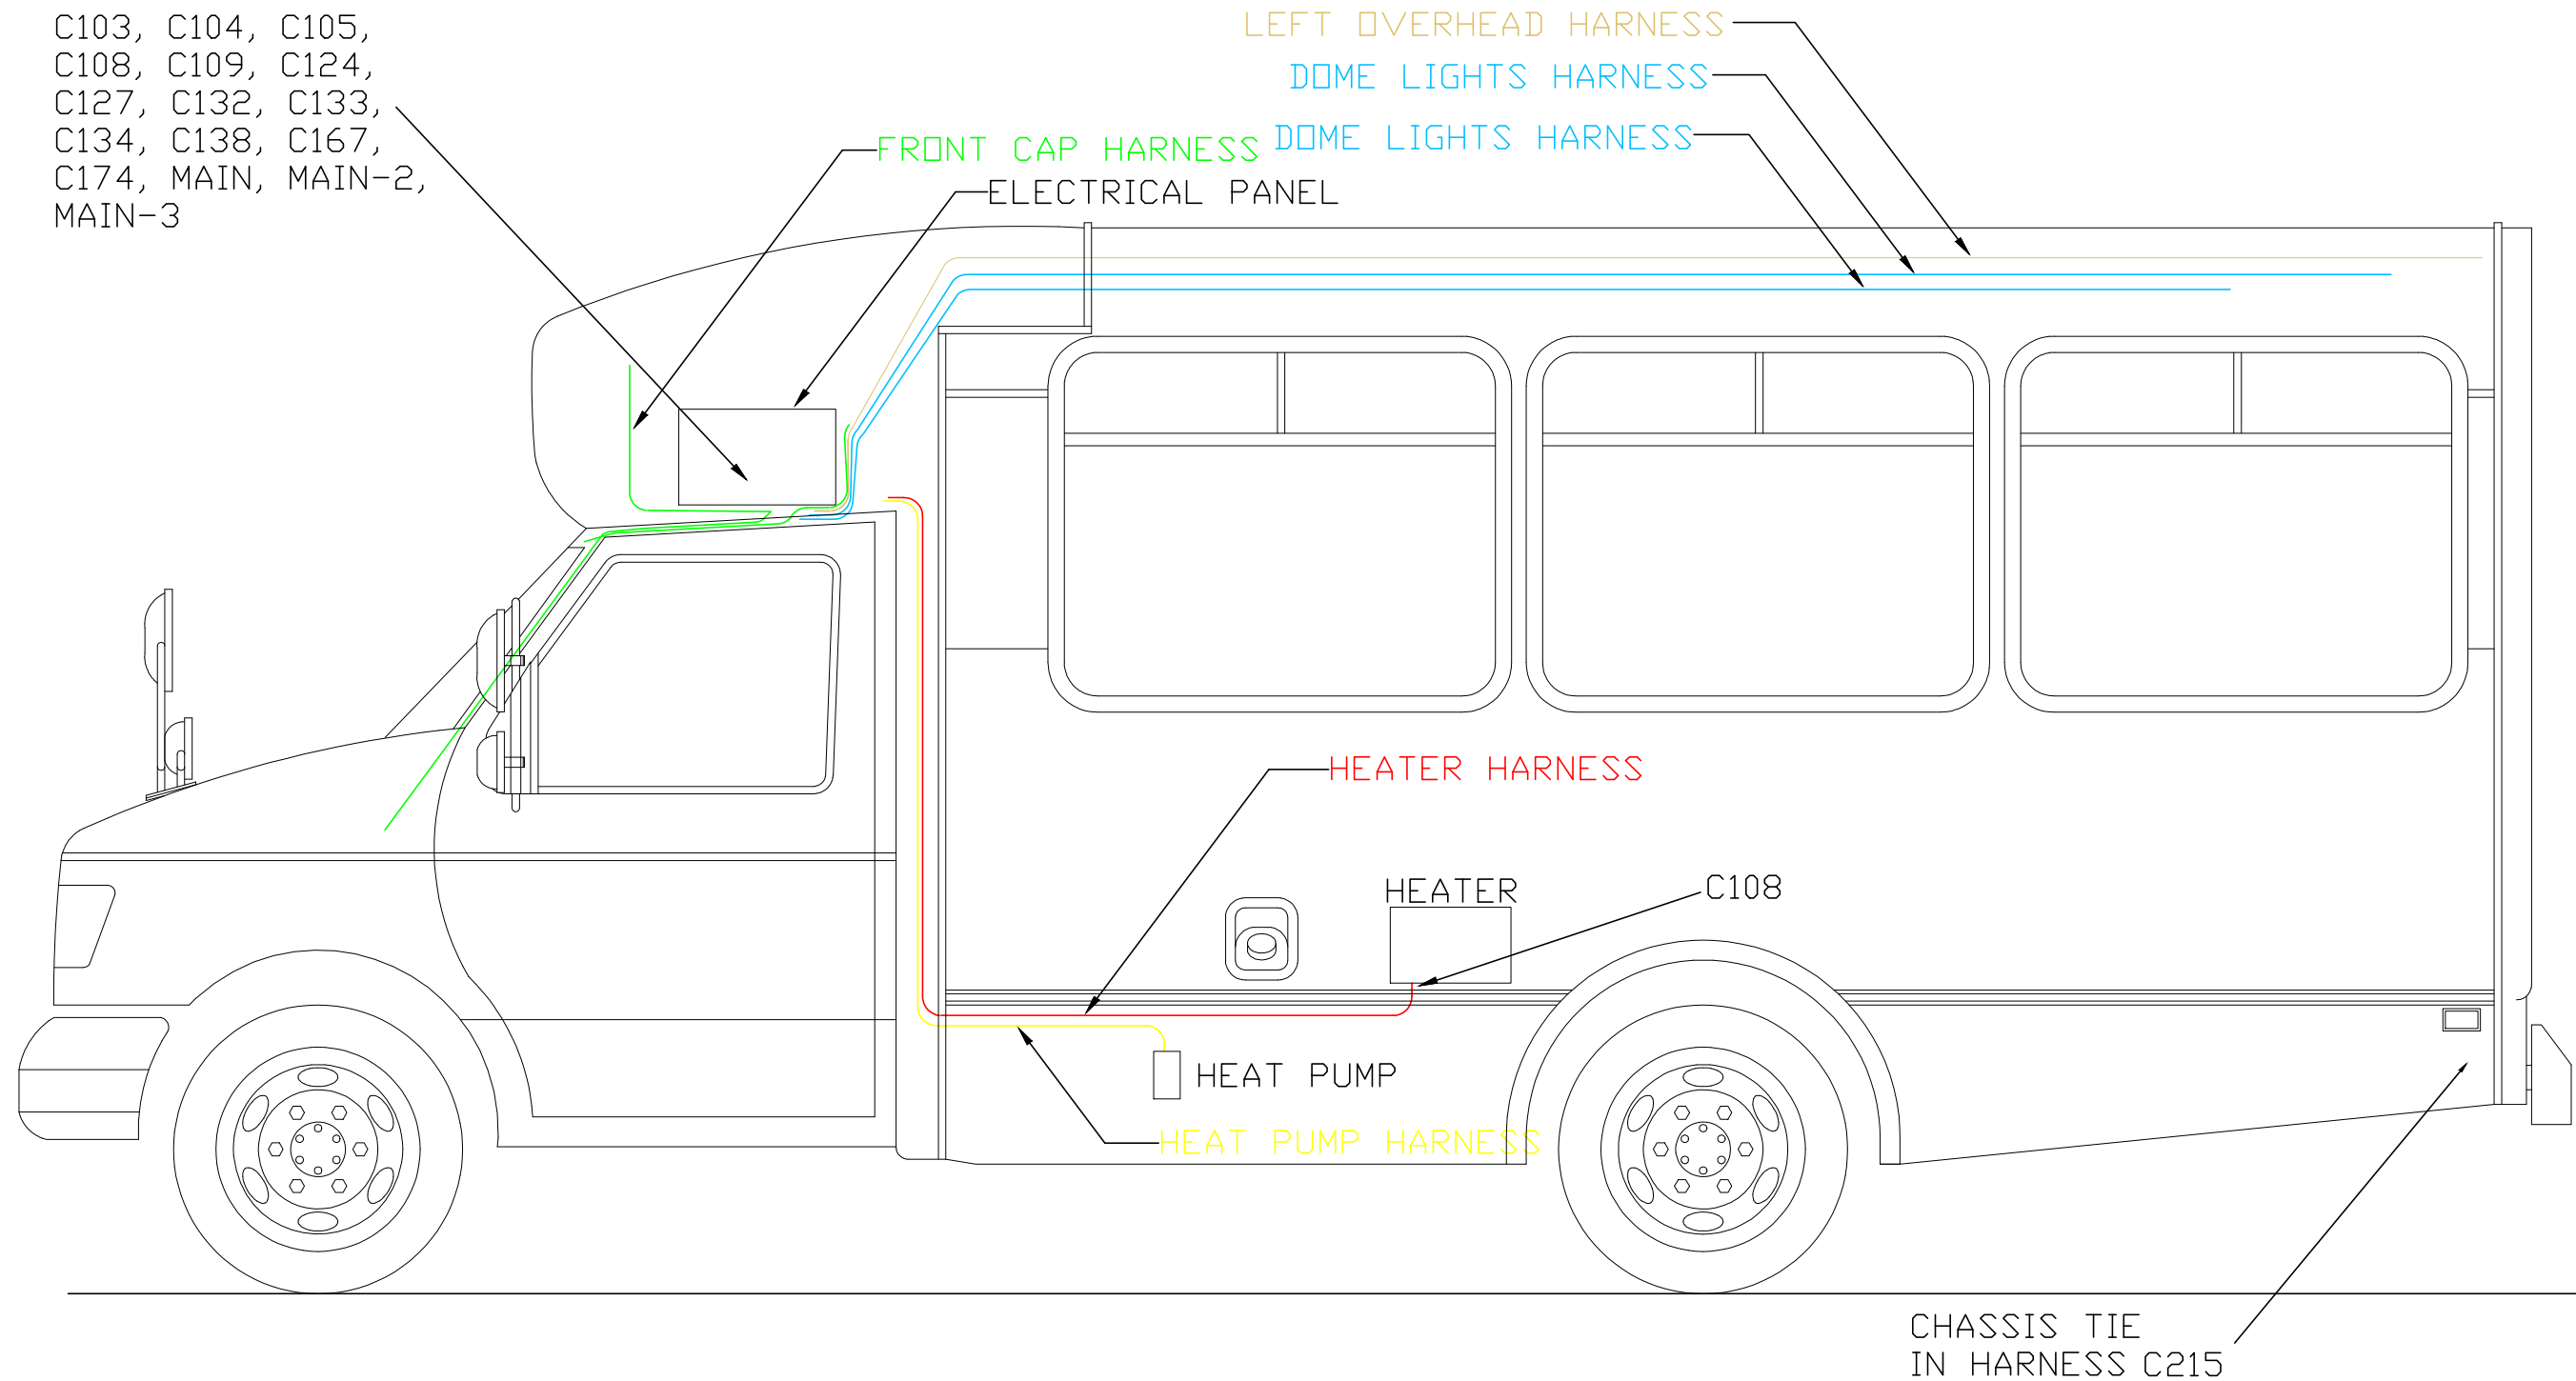

										 CHAMPION BUS INC. <small>a TECUMSEH company</small>		APPROVED BY: DD	ERM#: 	TITLE: ASBUILT GMT610 ANALOG	REFERENCE DWG: GMT610
R DATE 	ERN 	DESCRIPTION OF CHANGES 	BY 	R DATE 	ERN 	DESCRIPTION OF CHANGES 	BY 	DO NOT SCALE SCALE: N/A	DRAWN BY: CUSTOMER LB PDDT	MODEL: GMT610	DWG. NO. SHEET 1 OF 1	RELEASE DATE: 5/11/12	CBI UNIT NUMBERS: 		

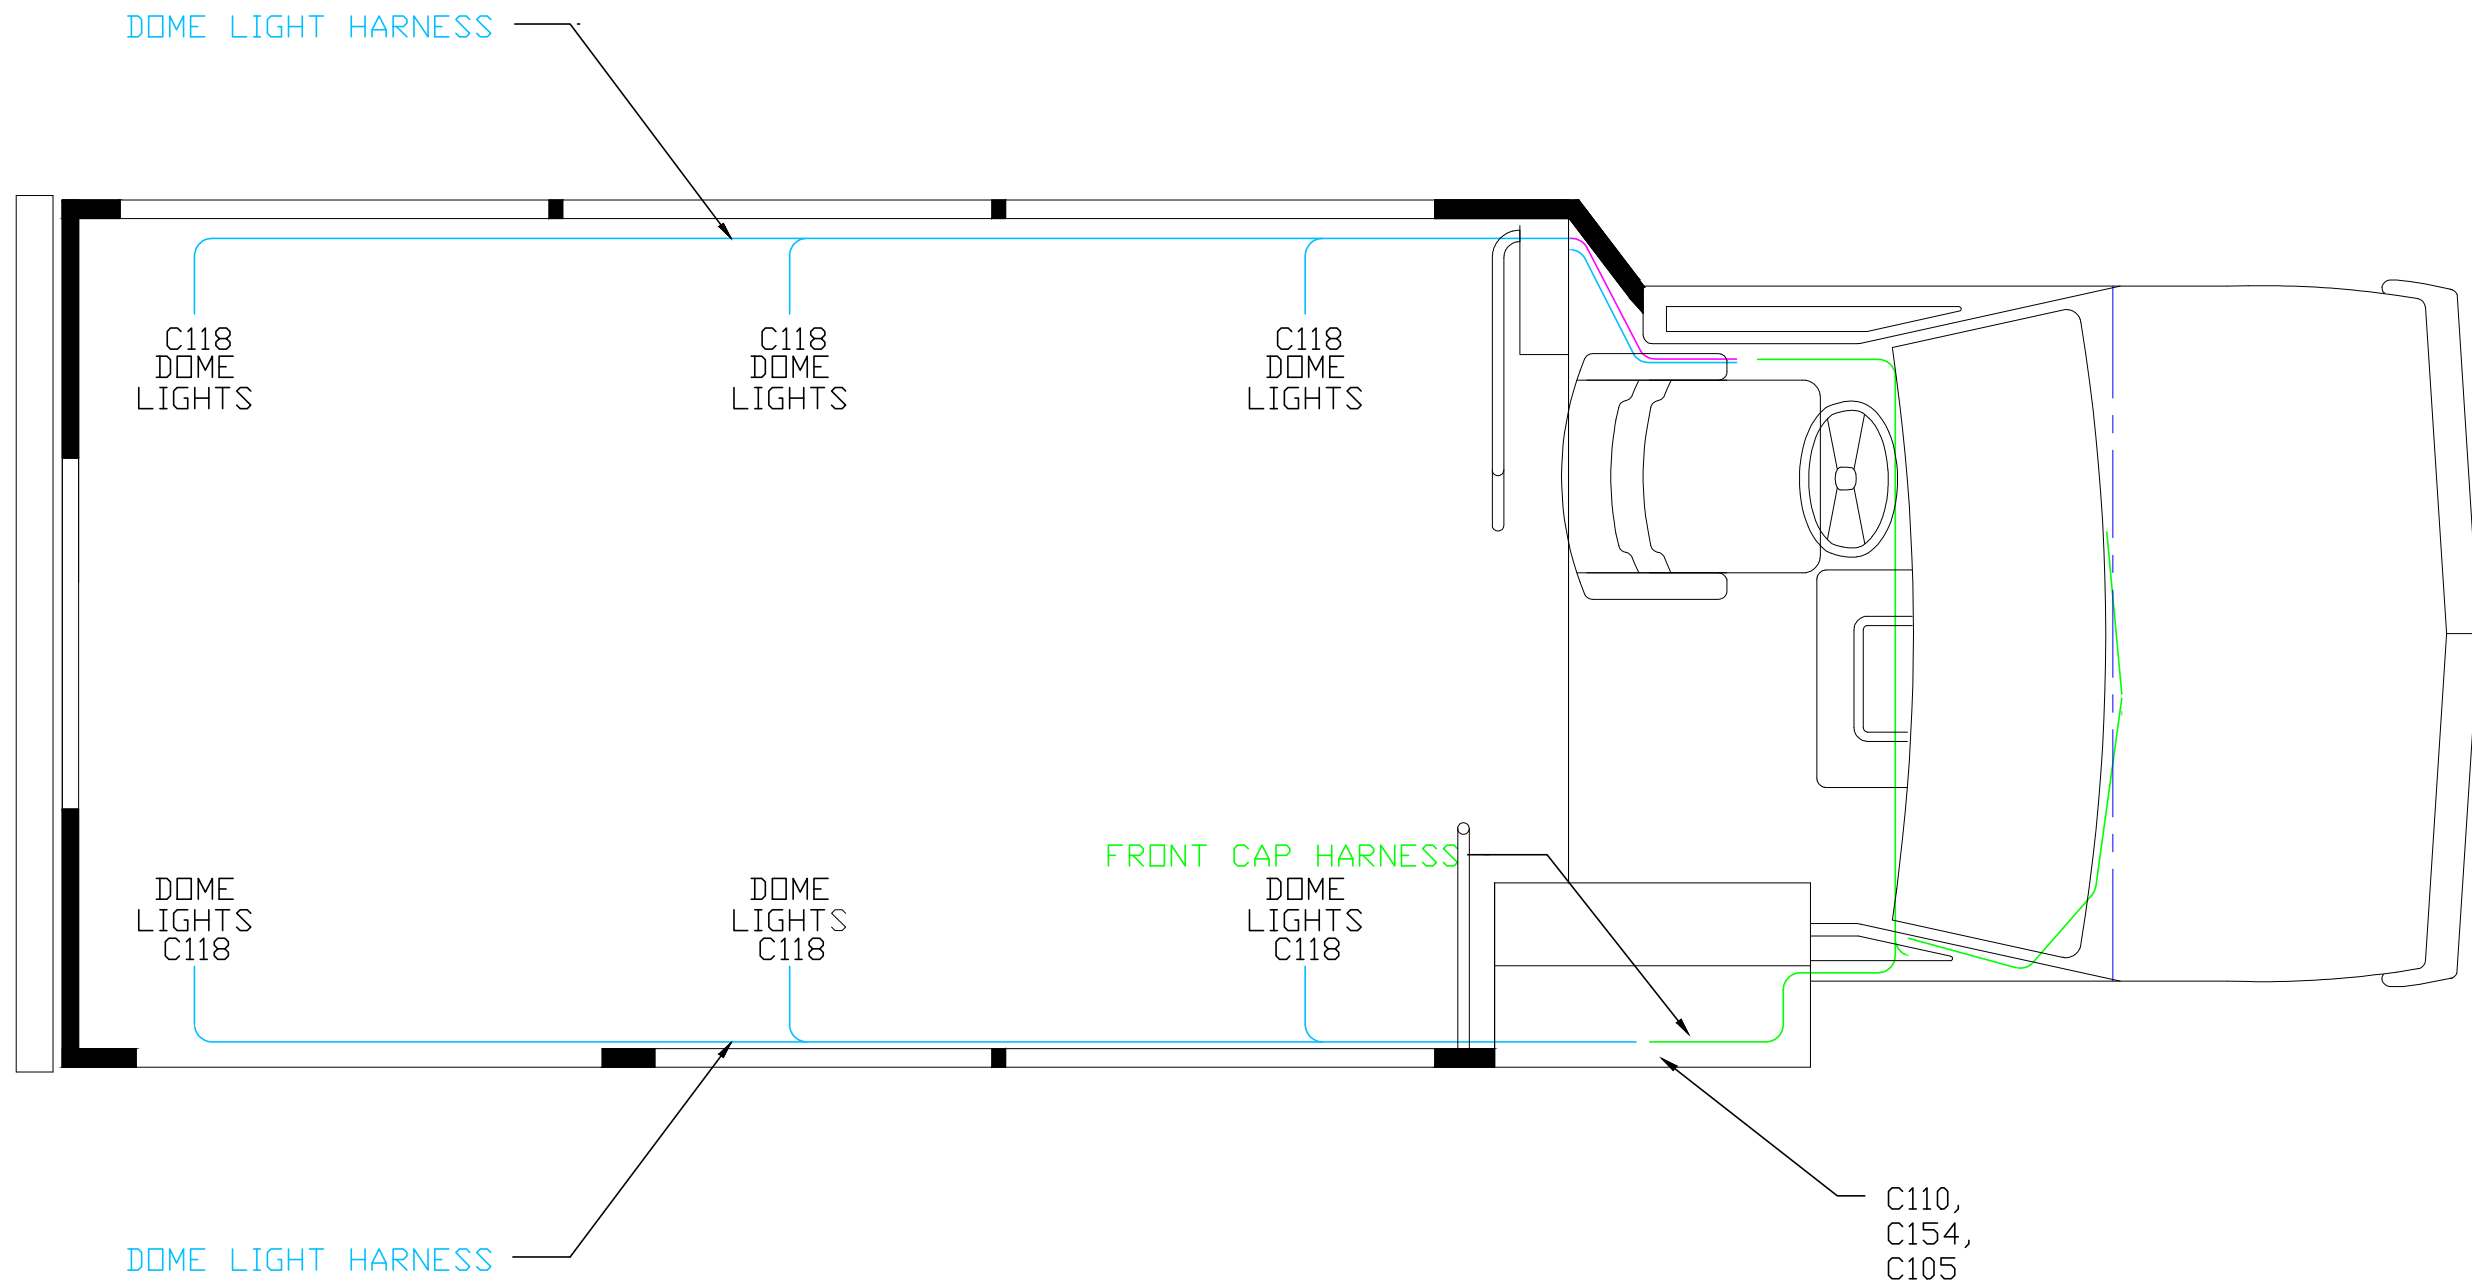

												APPROVED BY: DD	ERN#:	TITLE: ASBUILT GMT610 ANALOG	REFERENCE DWG: GMT610
R DATE ERN	DESCRIPTION OF CHANGES	BY R DATE ERN	DESCRIPTION OF CHANGES	BY R DATE ERN	DESCRIPTION OF CHANGES	BY R DATE ERN	DESCRIPTION OF CHANGES	DO NOT SCALE SCALE: N/A	DRAWN BY: CUSTOMER: LB PDDT	MODEL: GMT610	DWG. NO. SHEET 1 OF 1	RELEASE DATE: 5/11/12	CBI UNIT NUMBERS:		


FRONT CAP HARNESS

RADIO HARNESS

MARKER LIGHT
PLUG C 190


C100A, C100B, C187,

CONSOLE HARNESS

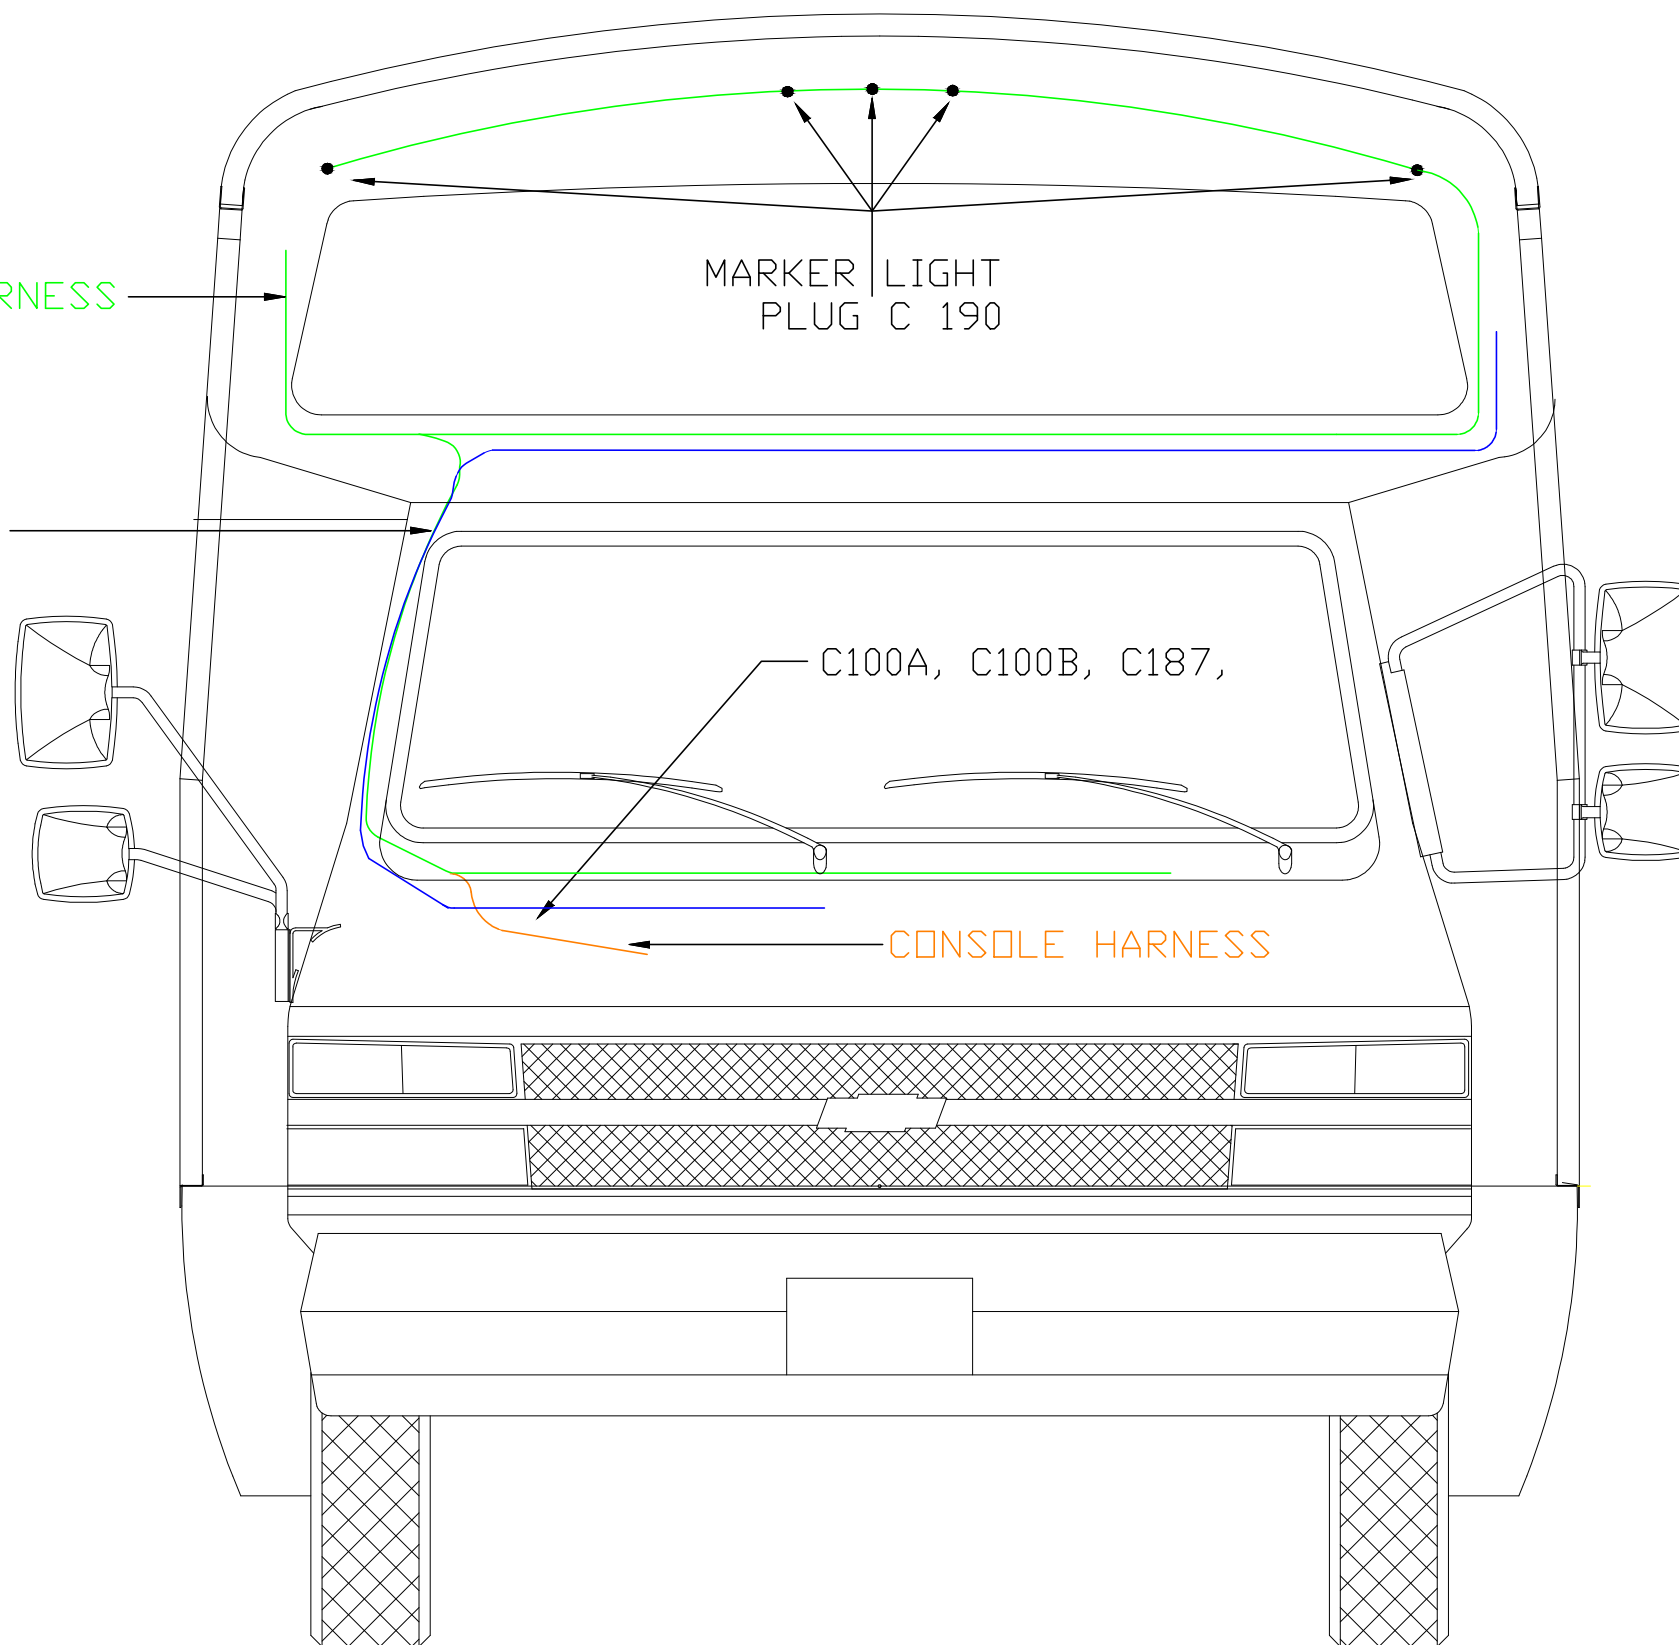


										APPROVED BY: DD		E/M:		TITLE: ASBUILT GMT610 ANALOG		REFERENCE DWG: GMT610													
R DATE		ERN		DESCRIPTION OF CHANGES		BY		R DATE		ERN		DESCRIPTION OF CHANGES		BY		M		DO NOT SCALE SCALE: N/A		DRAWN BY: CUSTOMER: LB PDDT		MODEL: GMT610		DWG. NO. SHEET 1 OF 1		RELEASE DATE: 5/11/12		CBI UNIT NUMBERS:	



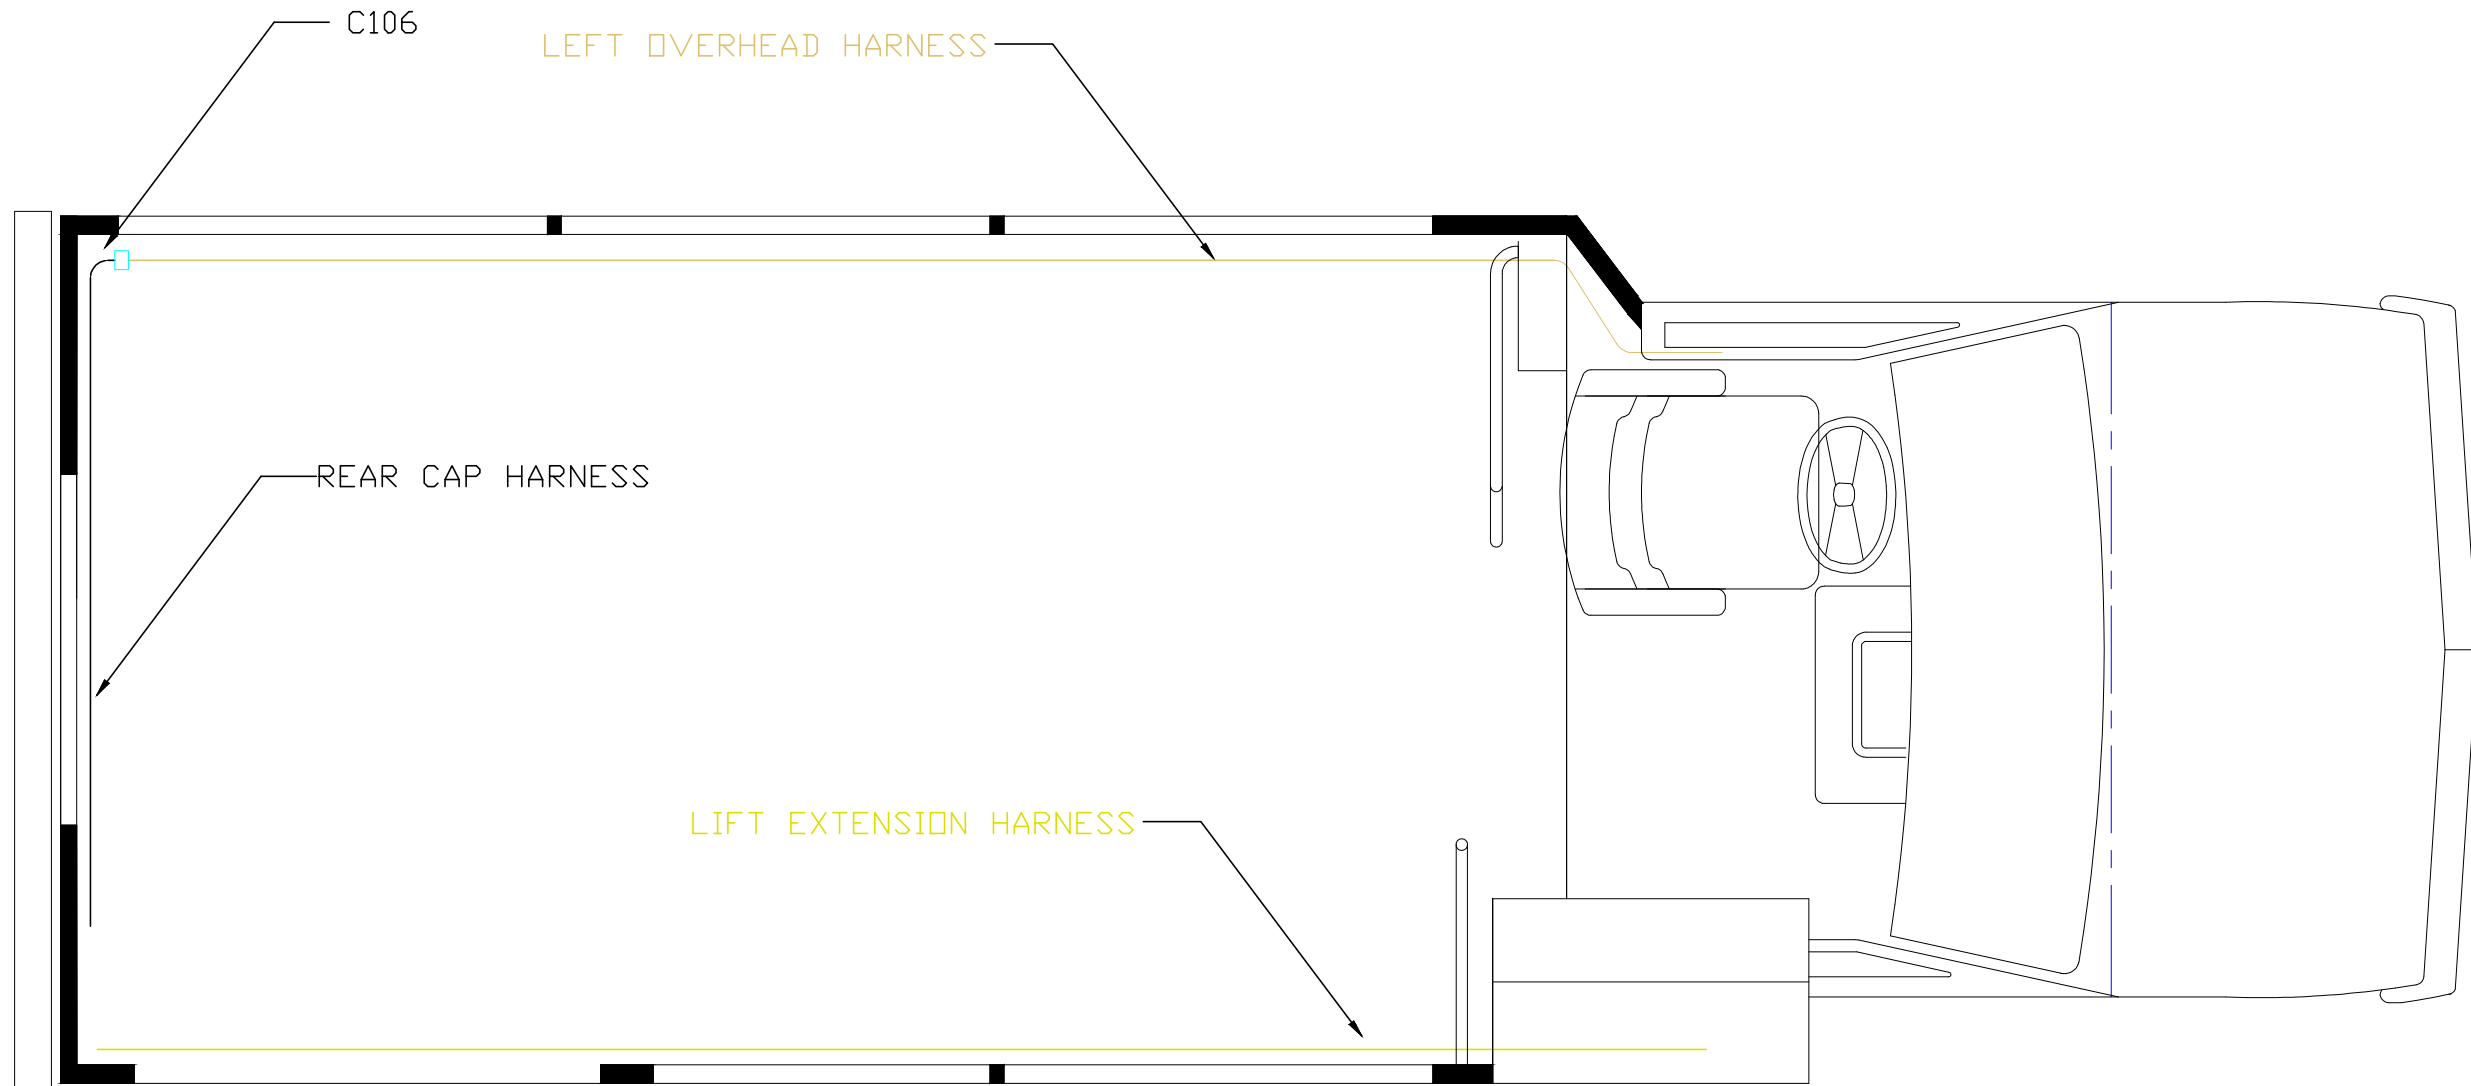

				 CHAMPION BUS INC. <small>— a TECO company —</small>				APPROVED BY: DD	ERN#:	TITLE: ASBUILT GMT610 ANALOG	REFERENCE DWG: GMT610
R DATE ERN	DESCRIPTION OF CHANGES	BY R DATE ERN	DESCRIPTION OF CHANGES	BY R DATE ERN	DESCRIPTION OF CHANGES	DO NOT SCALE SCALE: N/A	DRAWN BY: CUSTOMER: LB PDOT	MODEL: GMT610	DWG. NO. SHEET 1 OF 1	RELEASE DATE: 5/11/12	CBI UNIT NUMBERS:

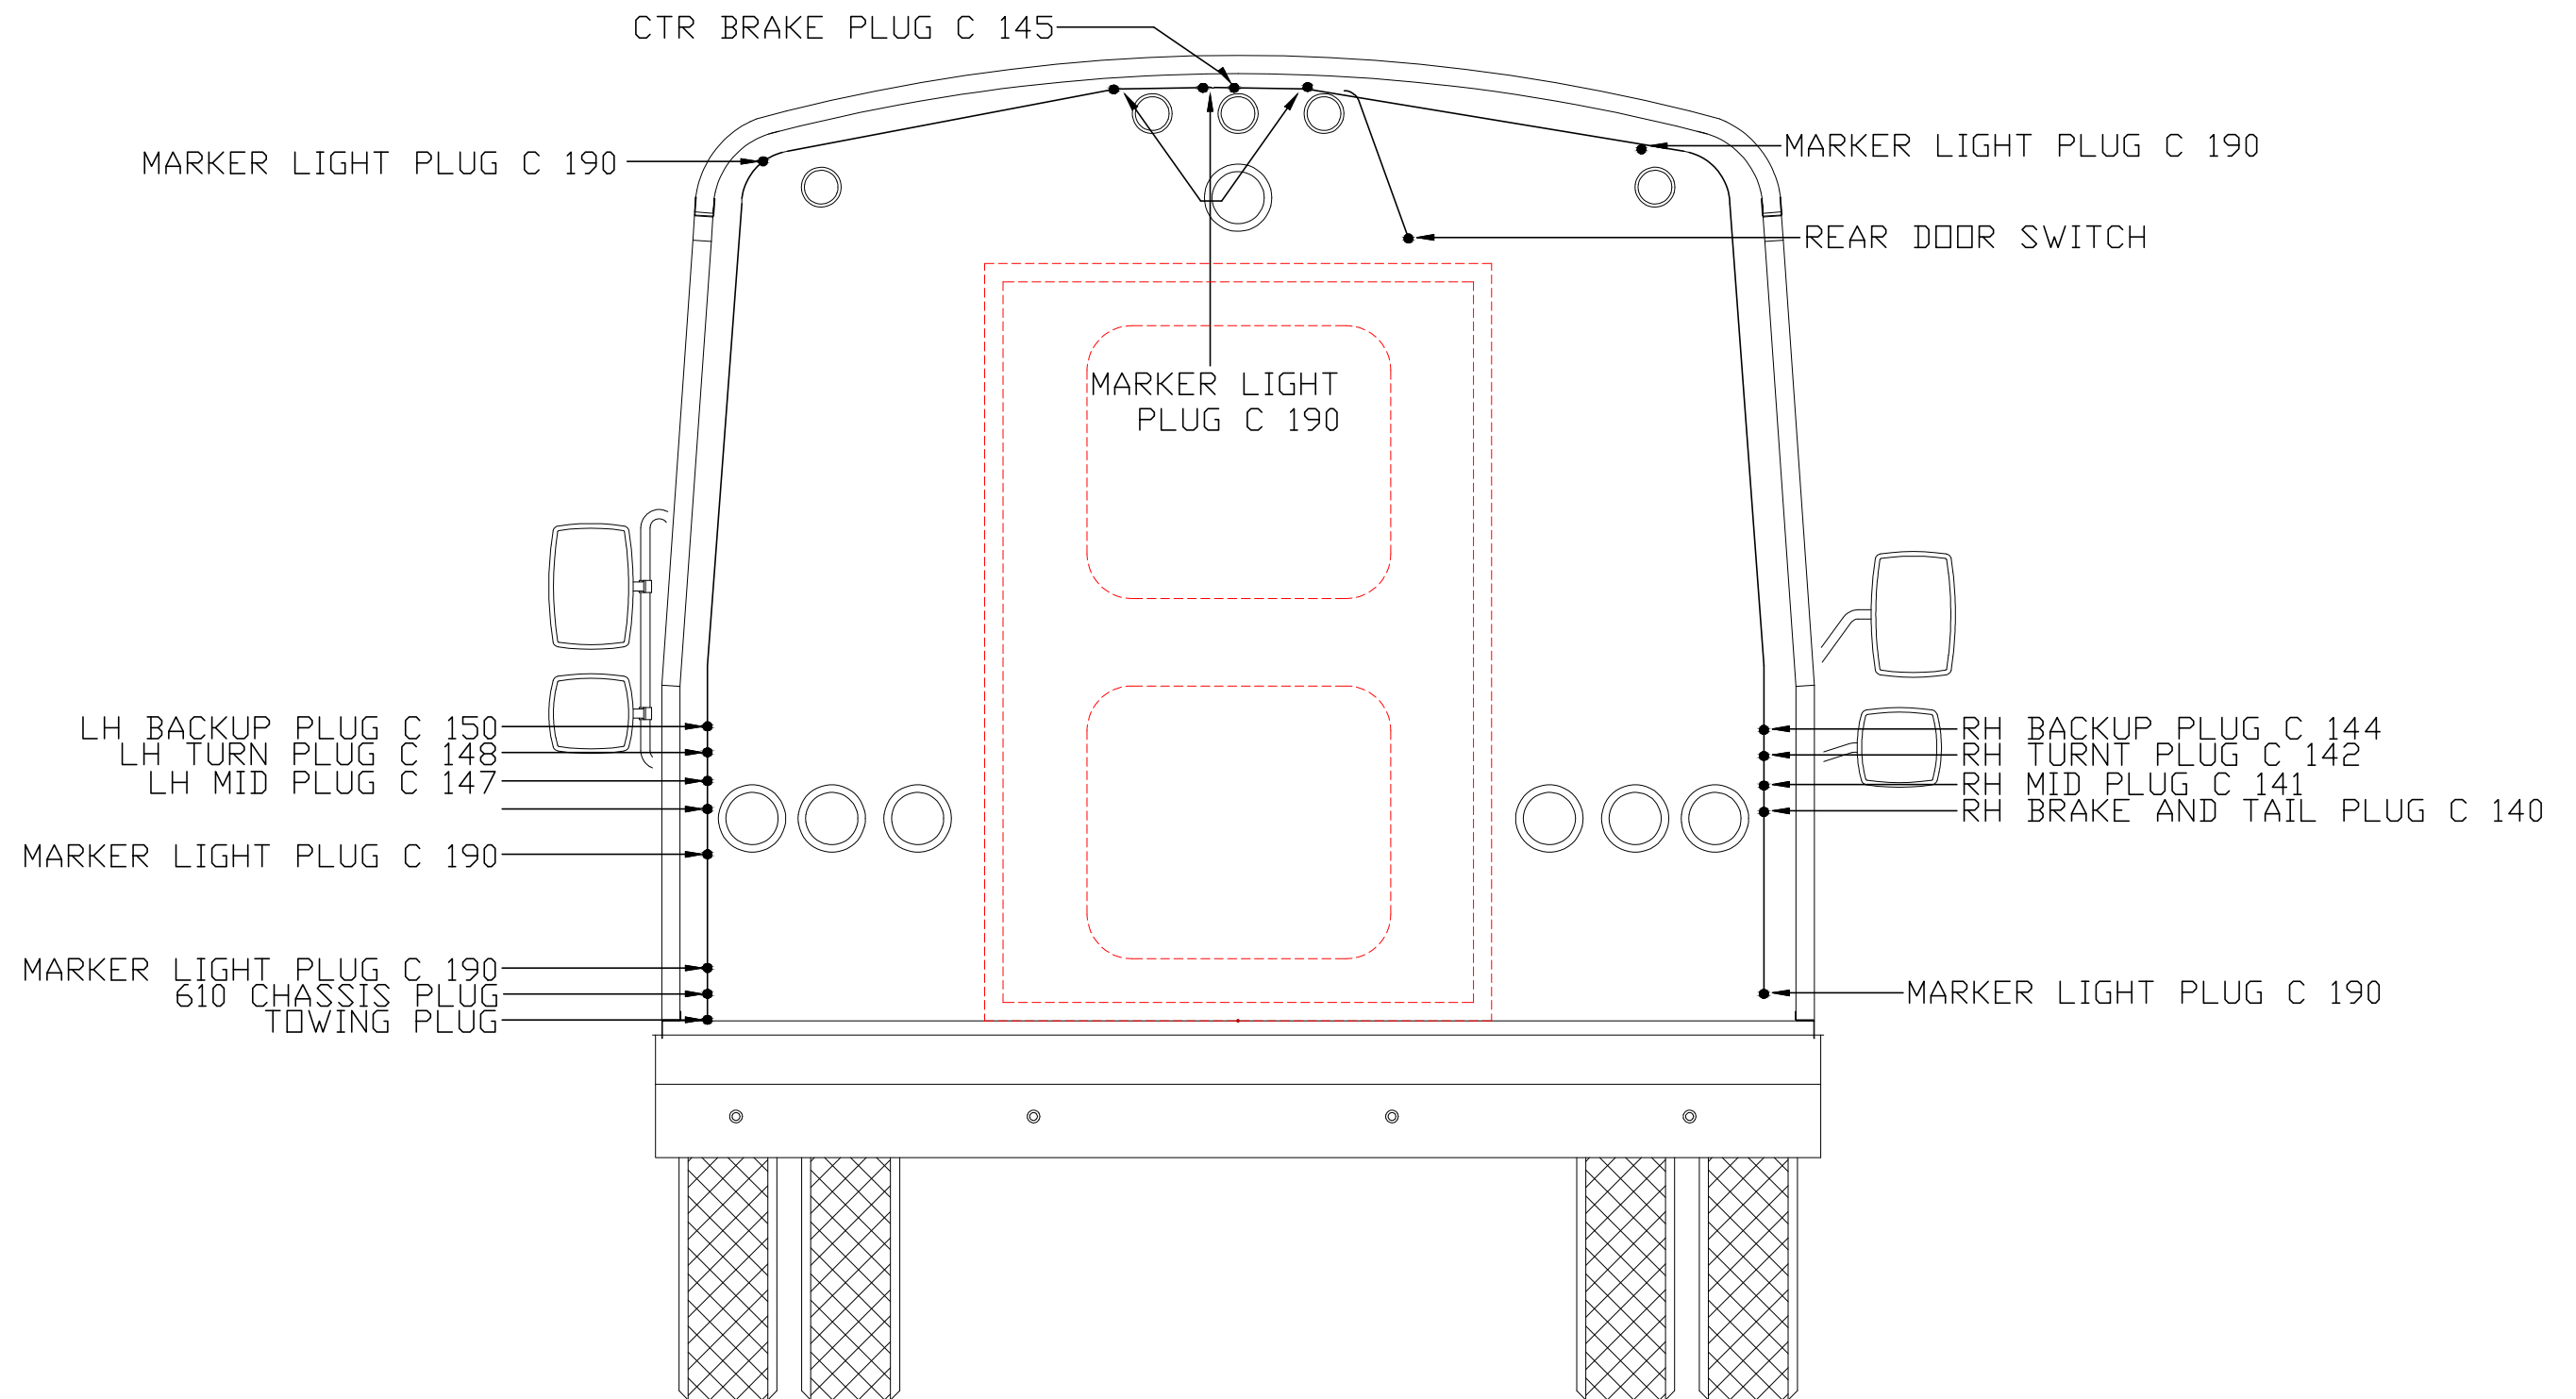

										APPROVED BY: DD P/IE: M DO NOT SCALE: N/A SCALE: N/A		ERN#: LB DRAWN BY: PDDT		TITLE: ASBUILT GMT610 ANALOG MODEL: GMT610		REFERENCE DWG: GMT610 RELEASE DATE: 5/11/12 SHEET 1 OF 1	
DATE	ERN	DESCRIPTION OF CHANGES	BY	DATE	ERN	DESCRIPTION OF CHANGES	BY	CHAMPION BUS INC. — a company —									